




SEWER DIVISION

Sketch of Service Here

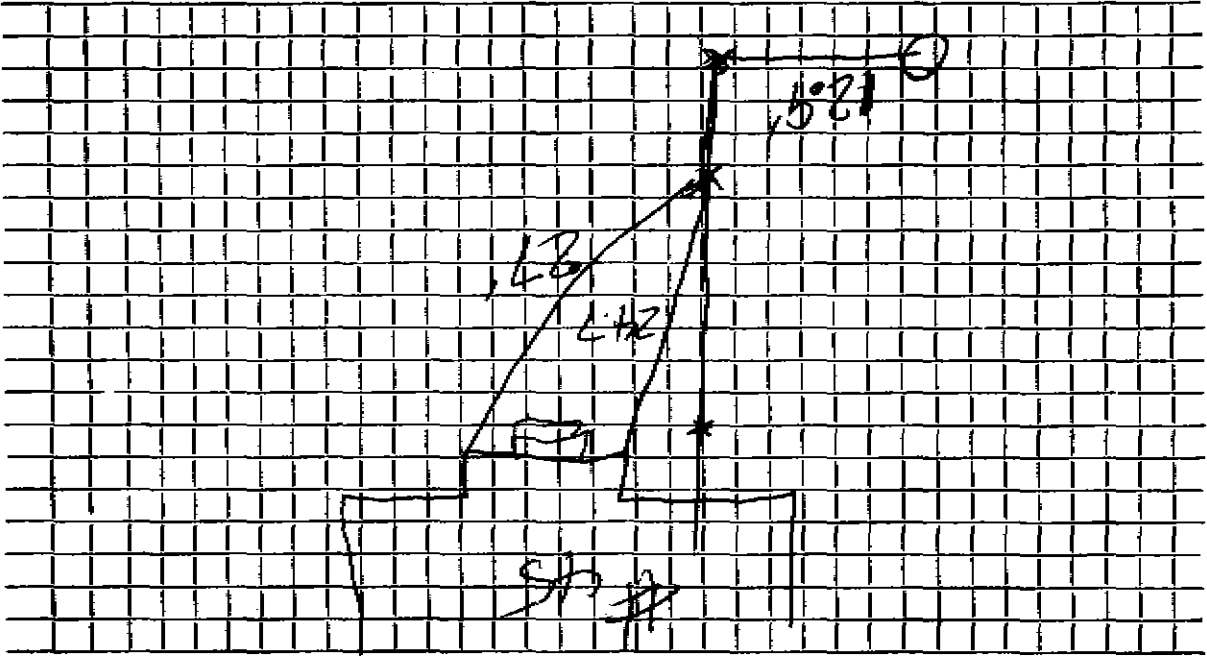

Connection made in Street. Work completed

Remarks: