

Name **Violet Kings**

Service No. **804**

Address **49 Parker Street**

8

49 Parker Street

Location **49 Parker Street**

Kind of Pipe

Size **6"**

Size of Main **8"**

~~MAINT~~ Renewal ~~XXXXXXXX~~ W.O. #6090

Location **MAY 27 1969**

Date		Material	Amount	Total	Date		Amount
1929							
4/23/69		Labor	63.34		4-11-69	Deposit	20.00
		10% O.H.	6.33		5-27-69	Retard	125.45
23 1/2'		6" Transite .88	20.68		4/23/69	Labor	76.81
1		90 Elbow	1.00		23 1/2'	6" Transite	20.00
		Bag cement	1.55		1	6" Plug	3.00
1 1/2		Dozen brick	.81		1	Bag cement	1.55
1/2		Bag fertilizer 4.00	1.00		1 1/2	Dozen brick	1.55
2		Yds. loam 3.50	7.00		2	Bag fertilizer 4.00	1.00
5		Lbs Grass seed 1.10	5.50		2	Yds. loam 3.50	7.00
1		Hr. trucking	3.00		5	Lbs. grass seed 1.10	5.50
1		" "	1.50		2	Ton hot top 5.80	11.60
1		" Shovel	6.50		2	Hrs. trucking 3.00	6.00
1 1/2		" Loader 4.00	2.00		1 1/2	" " 1.50	3.00
1 1/2		" Compressor 5.00	1.25		1 1/2	" Shovel	6.50
		Labor	124.55		1 1/2	" Loader 4.00	2.00
					1 1/2	" Compressor 5.00	1.25
					1 1/2	" Roller 3.00	1.50
					1 1/2	" Trailer	2.00
							151.32
					7-21-70	rays and paper	

Hesley Press, Inc., Lexington

TOWN OF LEXINGTON—BOARD OF PUBLIC WORKS

SEWER DIVISION

DATE _____

NO. _____

The undersigned applies for the construction of a particular sewer connecting No. 49 Parker St Street and hereby agrees to comply with the Rules and Regulations governing the construction and use of Particular Sewers, as now or at any future time established by the Board of Selectmen.


Am't. of Estimate \$ _____

Am't. Paid \$ _____

_____ Owner

Sketch of Service Here

49

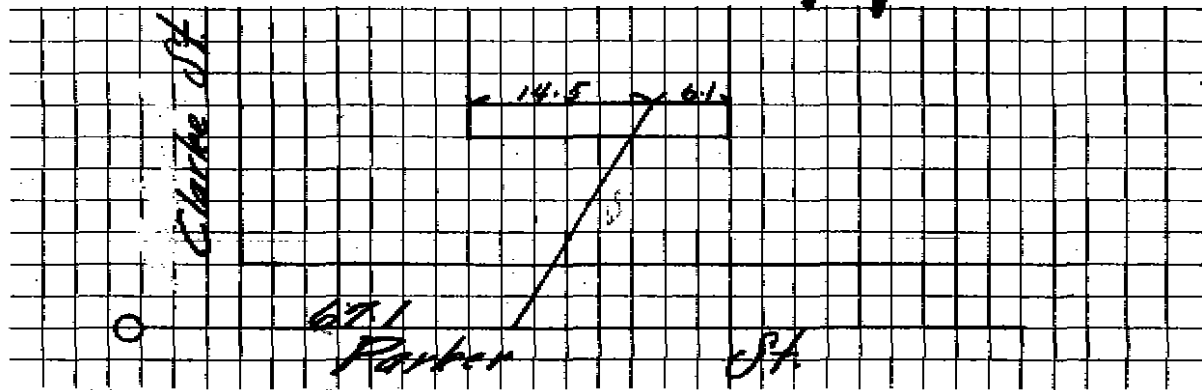

Connection made in _____ Street.

Work completed _____ 19

Remarks: