

Name Raymond Harrington

Service No. 17

Address 8 Parker Street

8 Parker Street

Location

Kind of Pipe

Size 6"

Size of Main 8"

Repair ~~Renewal~~ New Service W.O.#6461


Location AUG 5 1968

Date	Material	Amount	Total	Date	Amount
-16-68	Labor	90.16		4-9-68	300.00
-18-68	"	26.63	116.79	8-5-68	92.92
	10% O.H.	11.68	128.47		207.08
	32' 6" Transite pipe @.88		28.16		
	1 bag cement @1.55		1.55		
	20 Bricks		.90		
	1 ton Hot Top		5.80	12-26-63	Respond + Measure
	1 yd. loam		3.50	5-4-64	Repair made
	2 lbs grass seed @1.10		2.20		10' PVC Pipe
	5 hrs. Trucking @3.00		15.00		1-Mc-Pvc Fence
	2 hrs. Shovel @6.50		13.00		1-CI-Pvc Fence
	1 hr. Compressor		5.00		
	$\frac{1}{2}$ hr. Roller		1.50		
	$\frac{1}{2}$ hr. Trailer		2.00		
			207.08		

DATE _____

TOWN OF LEXINGTON — BOARD OF PUBLIC WORKS
SEWER DIVISION

Sketch of Service Here

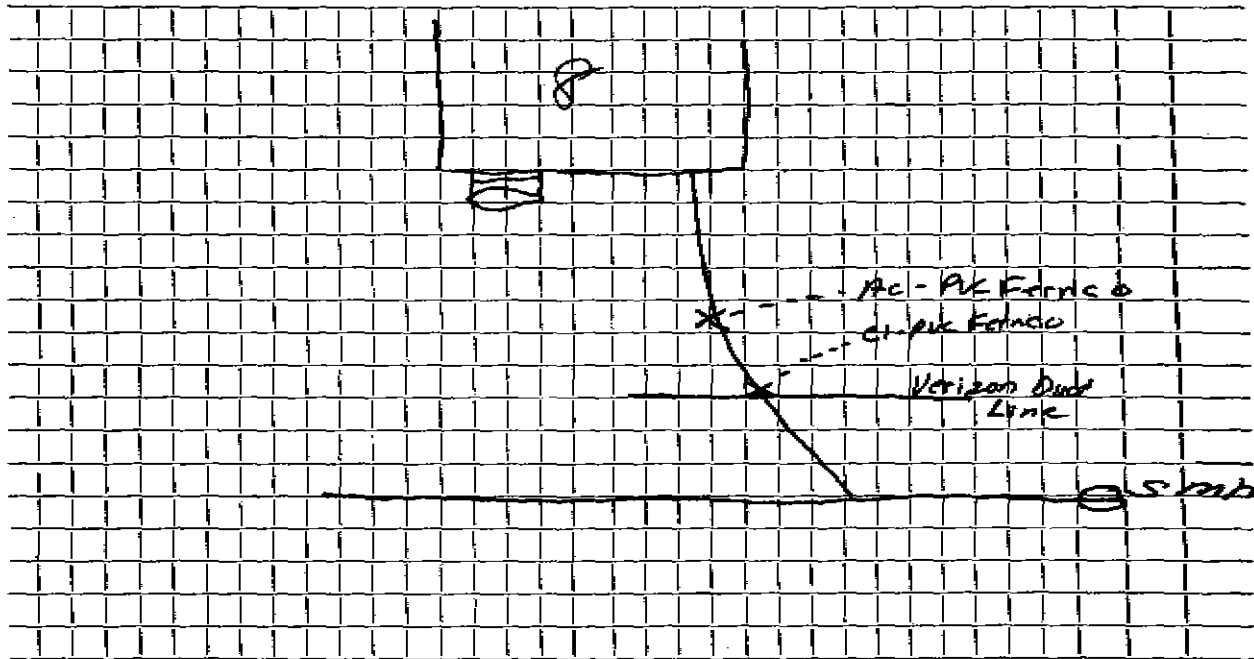

Connection made in Street. Work completed

Remarks:

.....

.....