

Name **Frank A. Yeomans**

Service No. 40

Address **9 Parker Street****9 Parker Street**

Location

*Comm. 9-3-57*

Kind of Pipe

Size **6"**Size of Main **8"**~~Repair Request~~ — **New Service**

Location

Date	Material	Amount	Total	Date		Amount
4/15/57	Labor	64 57		4-10-57	Deposit	# 15000
4/16/57	"	95 94		9/20/57	Partly refund and N.H.C. #62	2374
	10% overhead	16 05	176 56			<del>\$ 69 30</del>
	63' Transite Pipe @ .7020		44 23	9-16-58	Paid	17374 6930
	1 hr. Hough Loader		3 00			243 04
	1 hr. Compressor		3 00			
	3 hrs. Trucking @ .75		2 25			
	14x3 Patch		14 00			
			243 04			
	<b>Labor</b>					
					<i>Bill sent 9-5-57</i>	

**TOWN OF LEXINGTON—DEPT. OF PUBLIC WORKS**  
**SEWER DIVISION**

DATE.....

NO. ....


The undersigned applies for the construction of a particular sewer connecting No.....  
Street and hereby agrees to comply with the Rules and Regulations governing the construction and use of Particular  
Sewers, as now or at any future time established by the Board of Selectmen.

Am't of estimate \$.....

Am't Paid \$.....

..... Owner

**Sketch of Service Here**

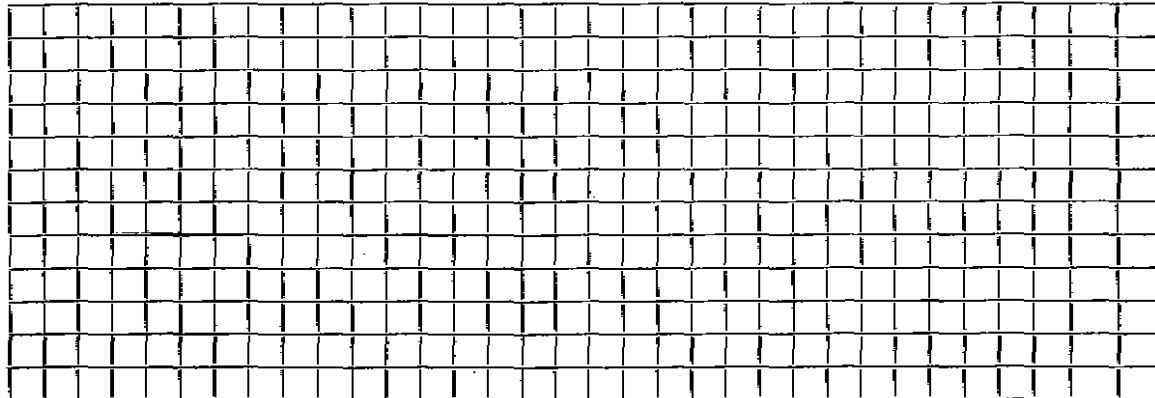

Connection made in..... Street.

Work completed.....19..

Remarks: