




# TOWN OF LEXINGTON — BOARD OF PUBLIC WORKS

## SEWER DIVISION

Sketch of Service Here **27**

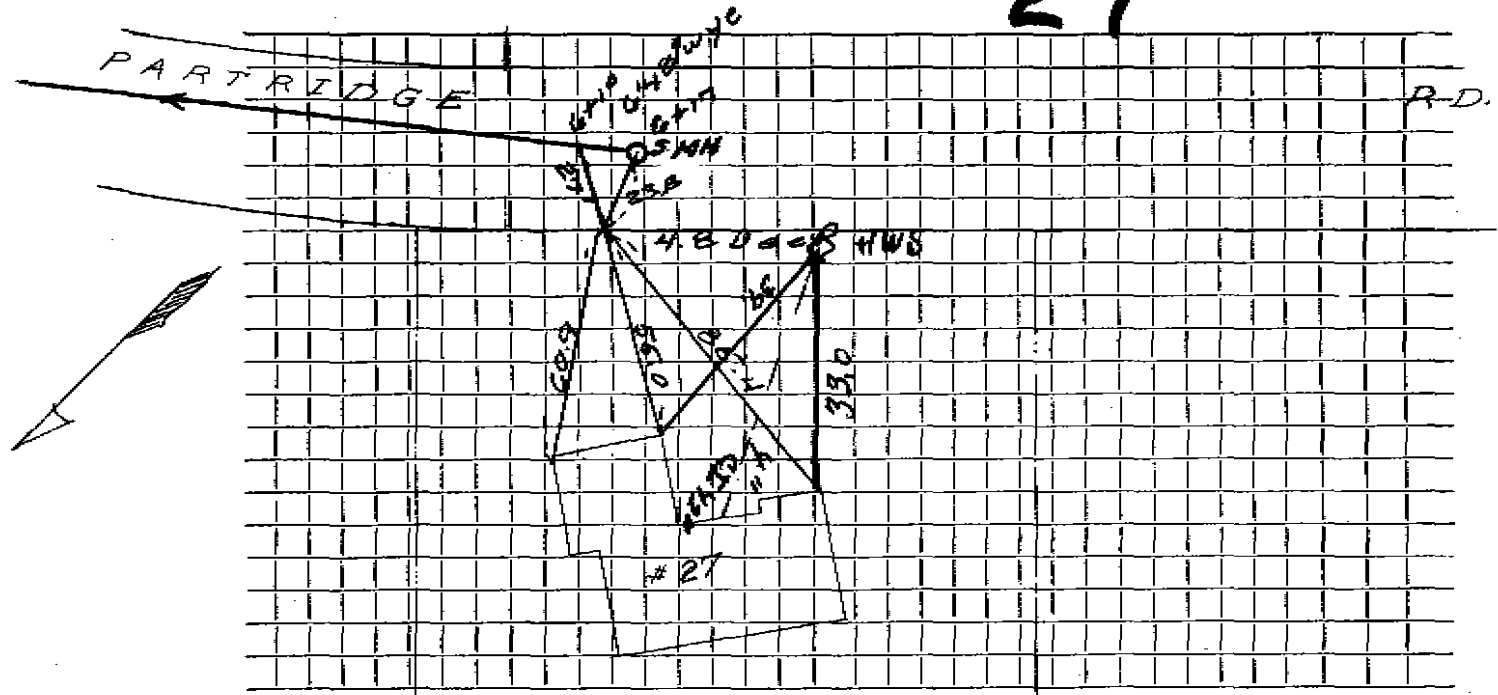

Connection made in ..... Lot 79 Street. Work completed .....

Remarks: .....

.....

.....