

Name

Service No.

Address

13 Partridge Rd.

13 Partridge Road

Location

Kind of Pipe

Size

6" A.C.

Size of Main

8" A.C.

Repair—Renewal—New Service


Location

Date	Material	Amount	Total	Date	Amount
10/3/72	23' 0" A.C. @ 7.50	\$172.50			
				10-3-72	
				23' 6" Transite	
				1 6"x 8" Wye	

DATE _____

TOWN OF LEXINGTON — BOARD OF PUBLIC WORKS

SEWER DIVISION

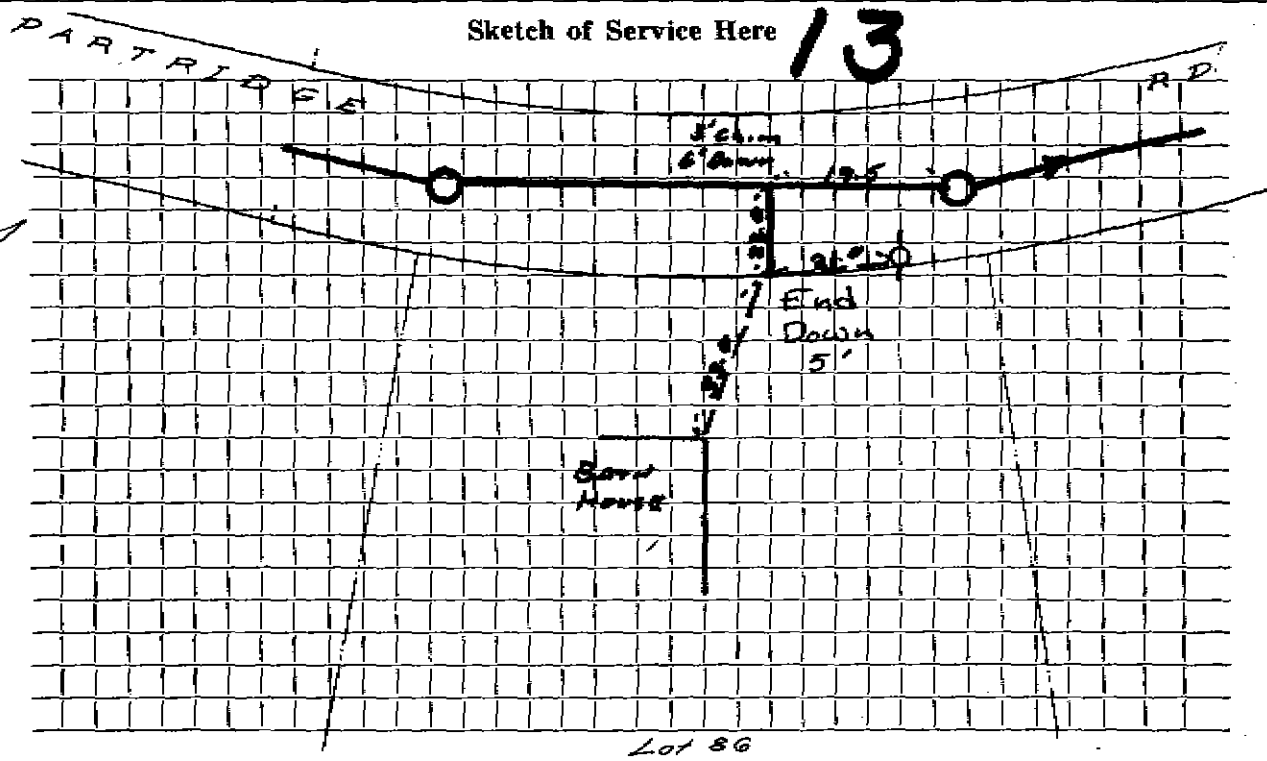

Connection made in Street. Work completed

Remarks:

.....

.....