

Name \_\_\_\_\_ Service No. \_\_\_\_\_  
 Address **15 PARTRIDGE RD.**  
**15 Partridge Road**  
 Location \_\_\_\_\_  
 Kind of Pipe \_\_\_\_\_ Size **C.A.C.** Size of Main **2 1/2".**  
 Repair—Renewal—New Service \_\_\_\_\_ Location \_\_\_\_\_


Date	Material	Amount	Total	Date	Amount
11/29/72	25.0 P.C.C.	187.50			
				11-29-72	
				25'	6" Transit
				1	6" X 8" Wye

DATE \_\_\_\_\_

TOWN OF LEXINGTON — BOARD OF PUBLIC WORKS

SEWER DIVISION

Sketch of Service Here **15**

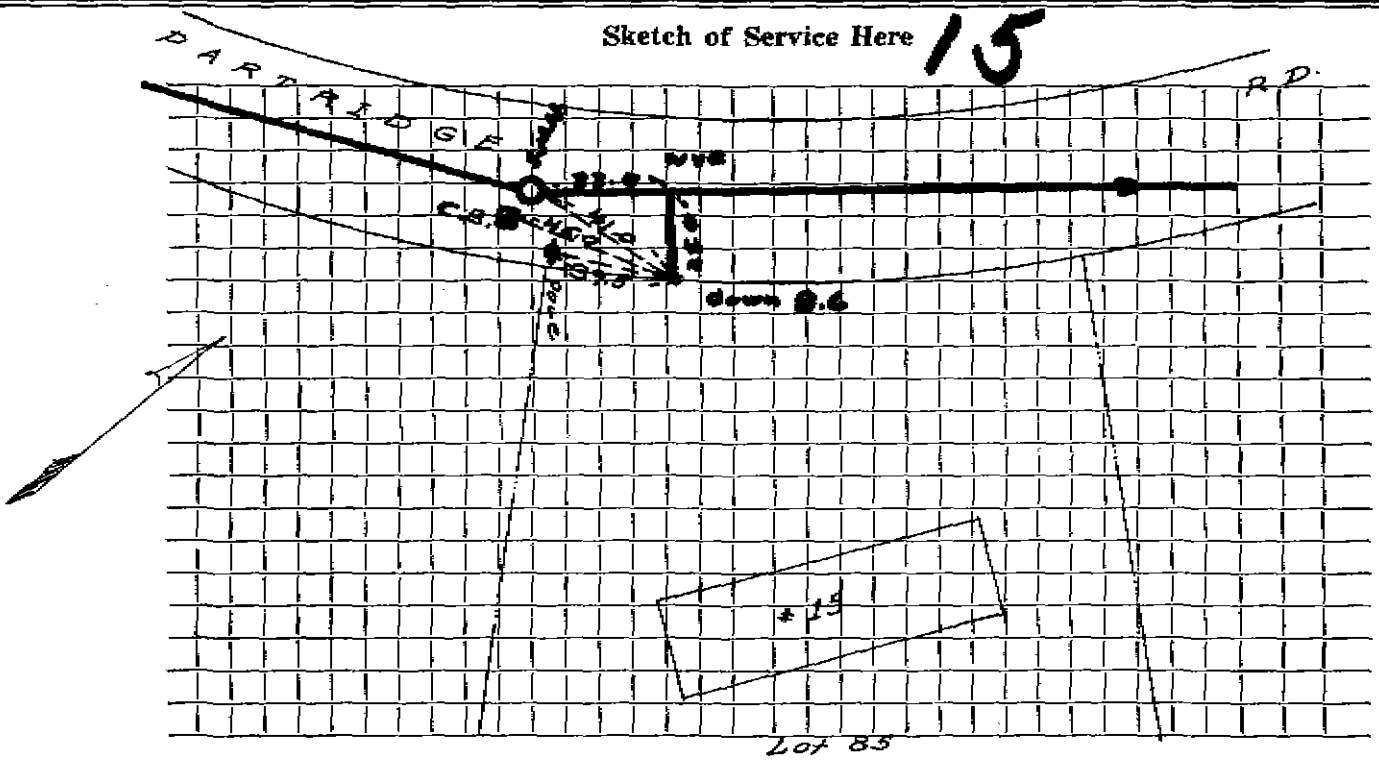

Connection made in ..... Street. Work completed .....

Remarks: .....  
.....  
.....