

Name **Nicholas Demas**

Service No. **150**

Address **#19 Partridge Rd.**

19 Partridge Road

Location

FEB 12 1973

Kind of Pipe

Size

6" A.C.

Size of Main

8" A.C.

Repair—Renewal—New Service

Lucente #2170


Location

Date	Material	Amount	Total	Date	Amount	
9/29/72	20' 6" A.C. @ 7.50	\$150.00	\$187.50	10/3/72	Deposit	187.50
10/3/72	65' 6" Transite			9-29-72		
	12' 4" Cast Iron			25'	6" Transite	
				1	6"x8" Wye.	

DATE _____

TOWN OF LEXINGTON — BOARD OF PUBLIC WORKS

SEWER DIVISION

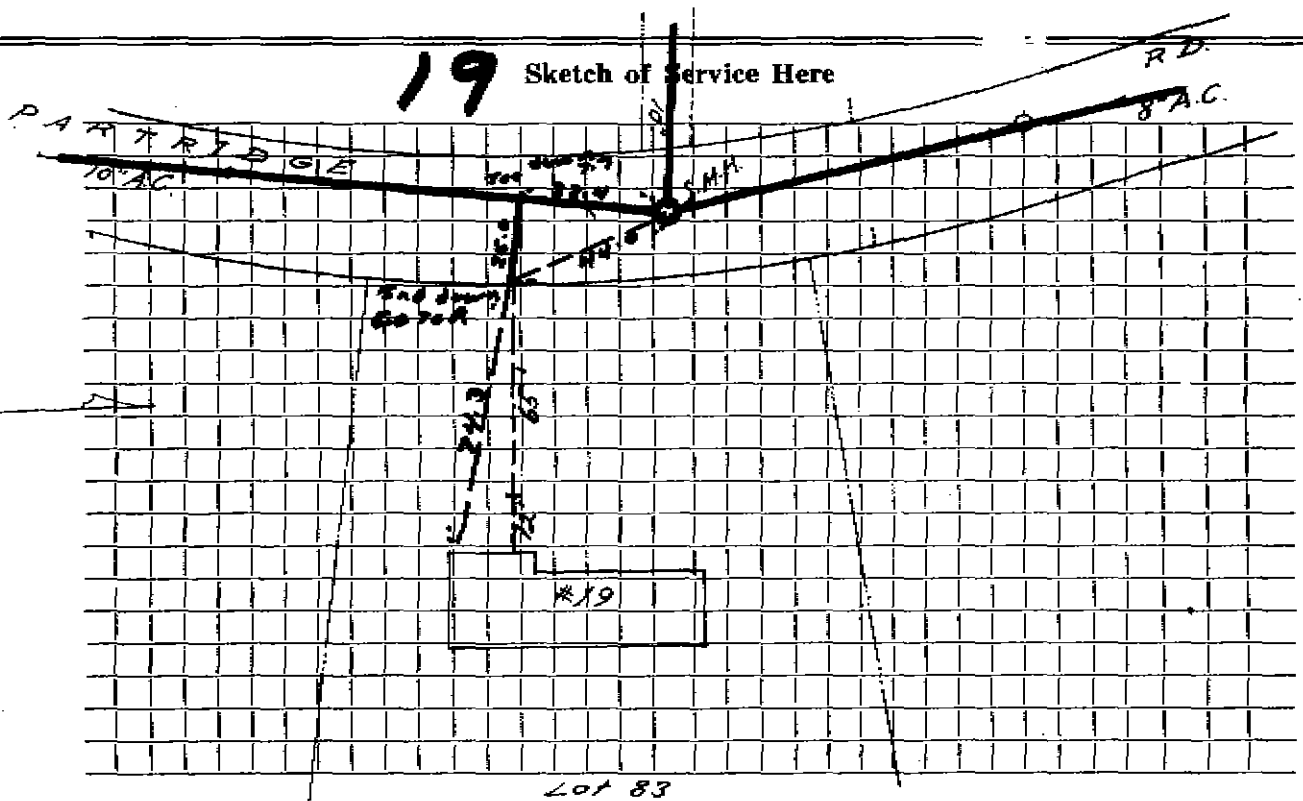

Connection made in Street. Work completed

Remarks:
.....
.....