






DATE

TOWN OF LEXINGTON — BOARD OF PUBLIC WORKS

SEWER DIVISION

Sketch of Service Here

29

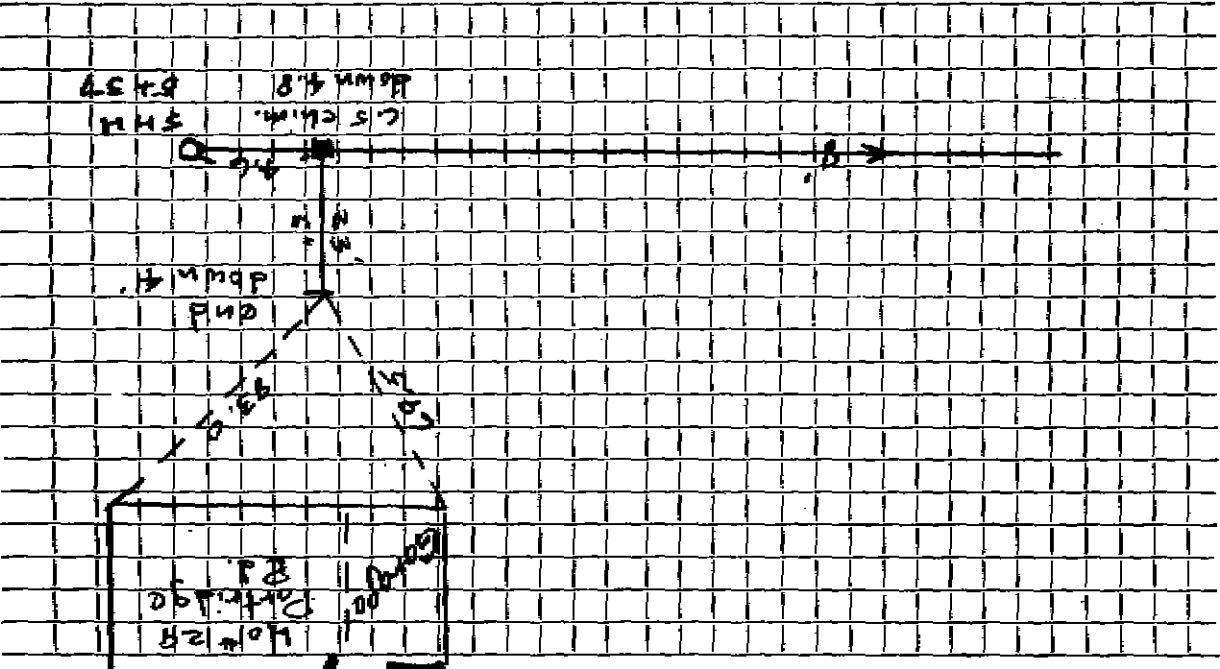

Work completed

Street

Partridge Rd

Connection made in


Remarks:

DATE OCT - 30 1997

TOWN OF LEXINGTON — BOARD OF PUBLIC WORKS

SEWER DIVISION

Sketch of Service Here

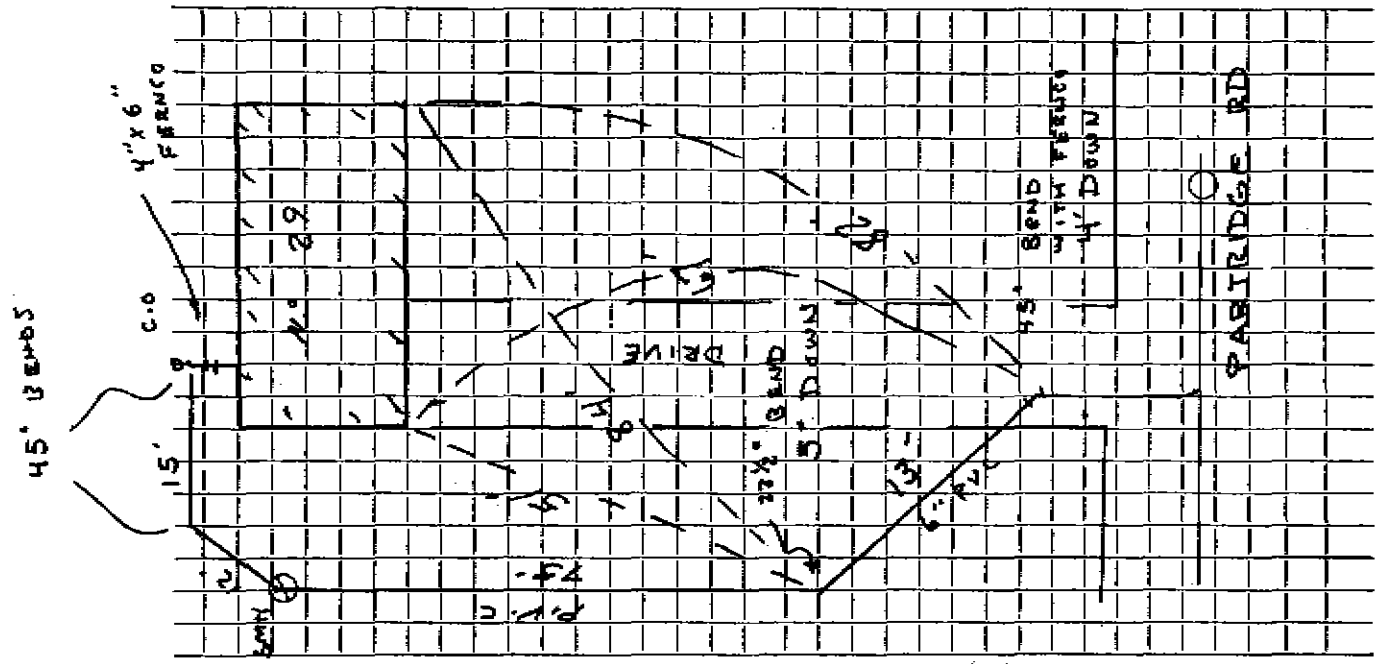

Connection made in PARTRIDGE Street. Work completed by SEWERMAN

Remarks: .....  
FIELD BOOK 97:4