


DATE 6/23/95

TOWN OF LEXINGTON — BOARD OF PUBLIC WORKS
SEWER DIVISION

Sketch of Service Here 31

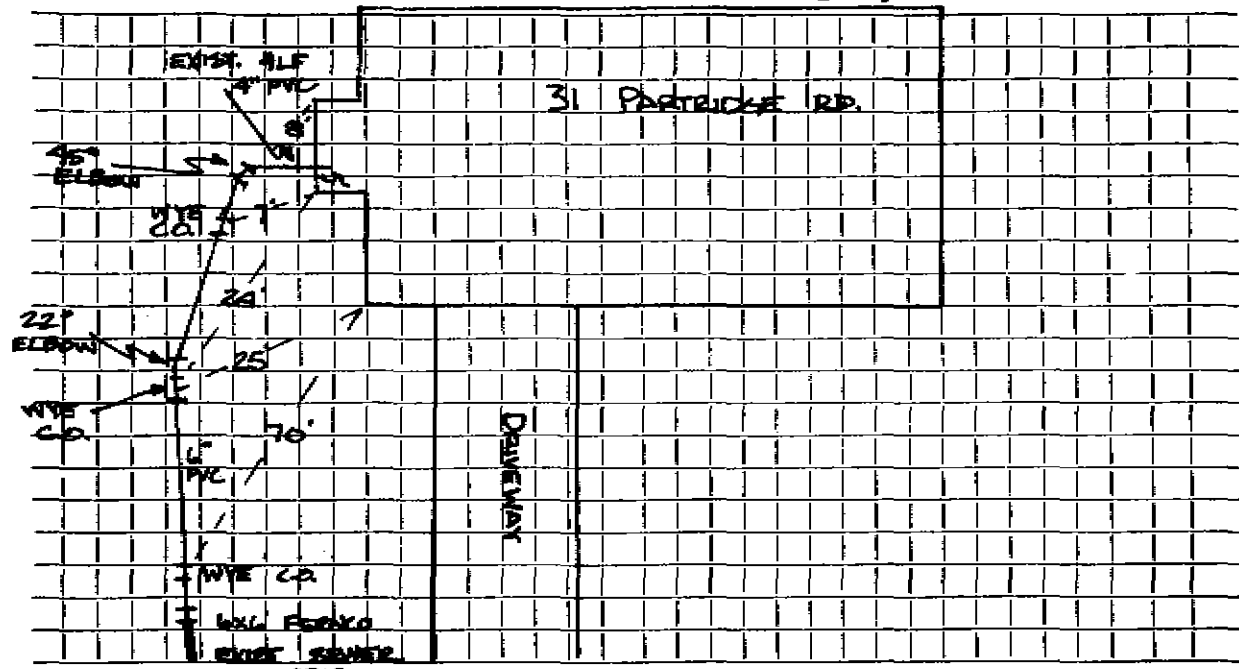

Connection made in .. PARTRIDGE .. RD. .. Street. Work completed .. Mc IVER .. BROS. ..

Remarks: ..
.....
.....