

Name Michael Edwards

Service No. 139 (75)

Address 32 Partridge Rd.

32 Partridge Road

Location

Kind of Pipe AC

Size 6"

Size of Main 8"

Repair—Renewal—New Service

Valeri Const. #2930


Location AUG 16 1976

Date	Material	Amount	Total	Date	Amount
<del>11-22-74</del>	<del>29' 6" AC @</del>	<del>10.00</del>	<del>290.00</del>	11/13/5	Deposit 290.00
1/21/75	137' 6" Transite Pipe				
	20' 4" Cast Iron Pipe			11-22-74	
					29' 6" Transite
					1 6" X 8" Wye
					1 6" X 30° Bend

DATE \_\_\_\_\_

TOWN OF LEXINGTON — BOARD OF PUBLIC WORKS  
SEWER DIVISION

Sketch of Service Here **32**

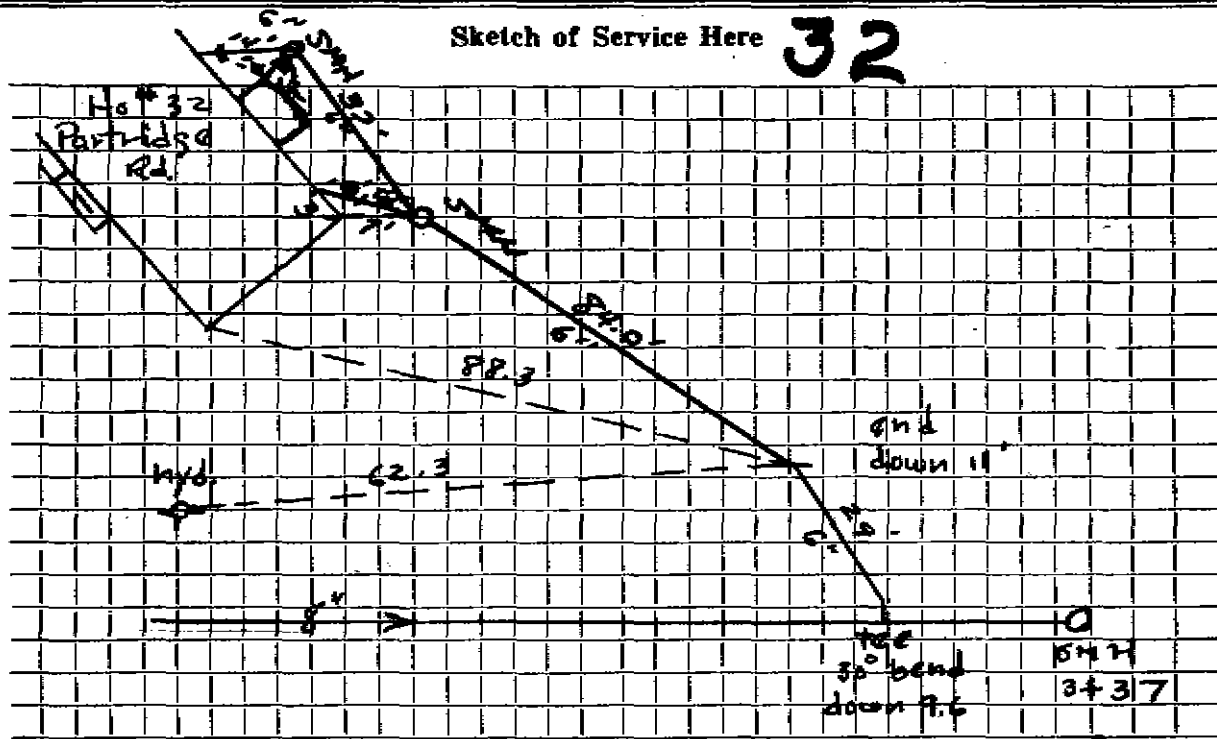

Connection made in Partridge Rd. Street. Work completed 11/24/75

Remarks: \_\_\_\_\_  
\_\_\_\_\_  
\_\_\_\_\_