

Name Mr. William Jackson

Service No.

84(25)

Address 33 Partridge Rd.

33 Partridge Road

Location

Kind of Pipe A.C.

Size 6"

Size of Main 8"

Repair—Renewal—New Service

Valeri #2739

Location AUG 16 1976


Date		Material	Amount	Total	Date	Amount
<del>4-21-74</del>	<del>31'</del>	<del>6" A.C. @</del>	<del>\$10.00 =</del>	<del>\$210.00</del>	8-29-75	Deposit 210 00
10/5/75	54'	6" Transite Pipe				
	2.5'	4" Cast Iron Pipe			11-21-74	
						2' 6" Transite
						1 6"x8" Wye

DATE \_\_\_\_\_

TOWN OF LEXINGTON — BOARD OF PUBLIC WORKS

SEWER DIVISION

Sketch of Service Here **33**

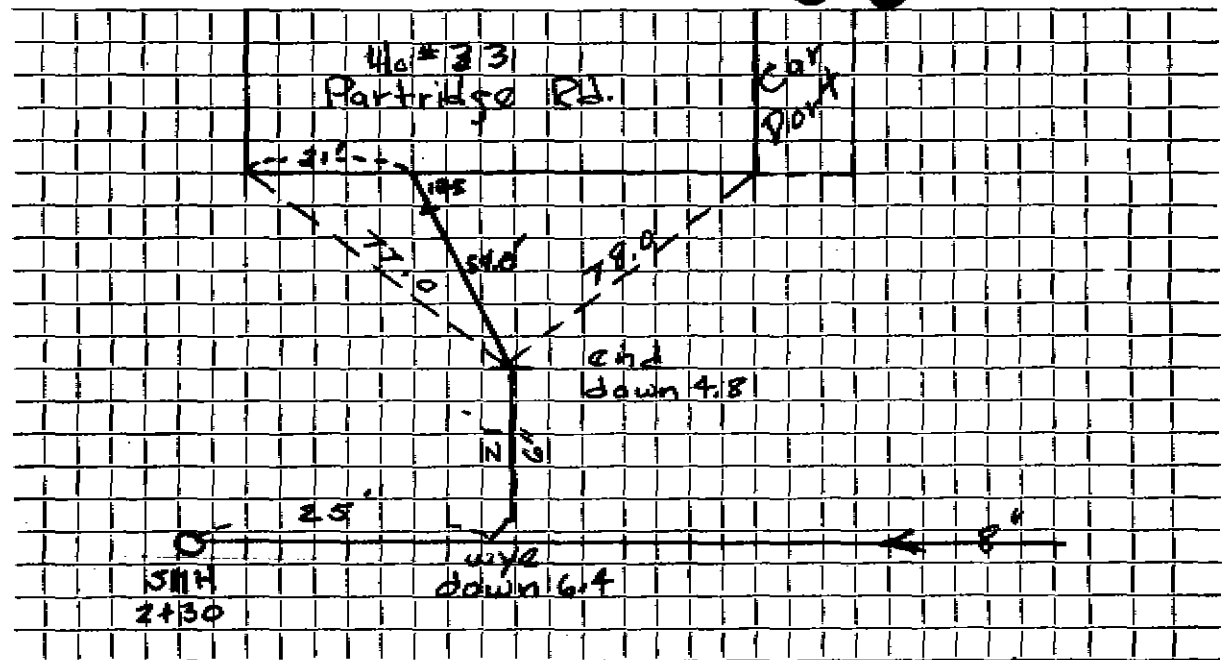

Connection made in Partridge Rd. Street. Work completed 9/5/75

Remarks: \_\_\_\_\_  
 \_\_\_\_\_  
 \_\_\_\_\_