

Name Michael Miller

Service No. 27

Address 5 Partridge Road

Lot #90 5 Partridge Road Location

Kind of Pipe

Size 6"

Size of Main 8"

Repair—Renewal—New Service Valeri #1346

Location MAY 27 1969


Date		Material	Amount	Total	Date	Amount
69	23'	6" Transite pipe @10.00		230.00	5-8-69	230.00
13-69	49'	6" Transite pipe				
	10'	4" Cast Iron pipe				

DATE _____

TOWN OF LEXINGTON — BOARD OF PUBLIC WORKS

SEWER DIVISION

Sketch of Service Here **5**

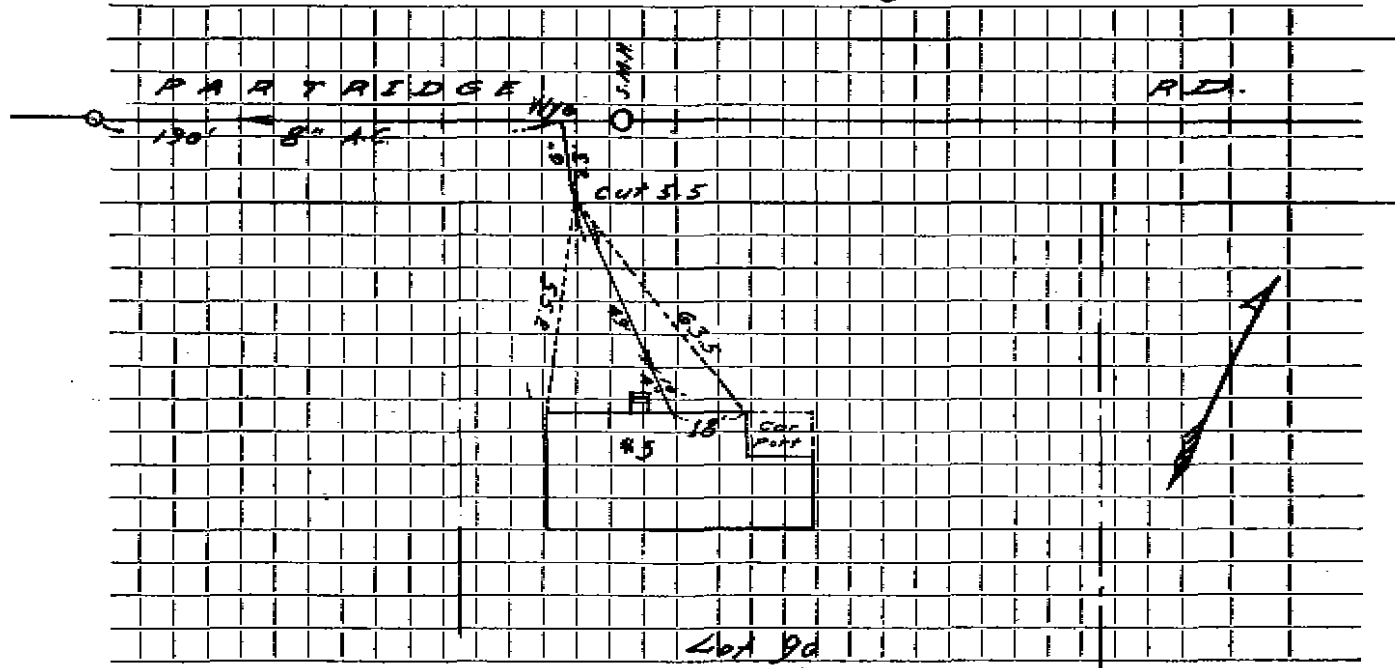

Connection made in Street. Work completed

Remarks:

.....

.....