

Name Milton Dietz

Service No. 89

Address 6 Partridge Road

Location Lot #62 6 Partridge Road

Kind of Pipe

Size 6"

Size of Main 8"

Repair—Renewal—New Service Valeri #1445

Location DEC 22 1969


Date	Material	Amount	Total	Date	Amount
969	31' 6" Transit pipe @10.00		310.00	8-22-69	310.00
26/69	165' 6" Transit pipe				
	10' 4" Cast Iron pipe			1969	
				31' 6" Transite	
				1 6" X 8" Wye	

TOWN OF LEXINGTON — BOARD OF PUBLIC WORKS

SEWER DIVISION

Sketch of Service Here

6

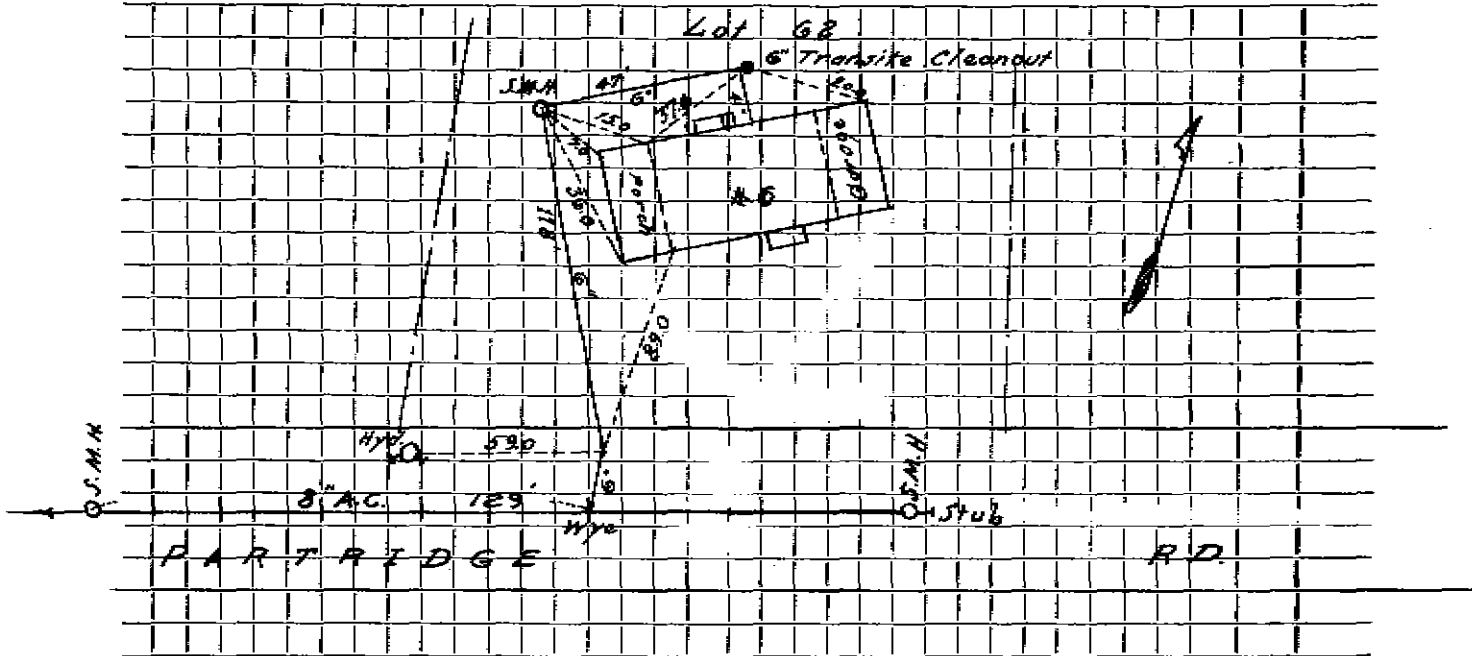

Connection made in Street. Work completed

Remarks:

.....

.....