

Name

Service No.

Address #1 Patricia Terrace (Vacant lot)

1 Patricia Terrace

Location

Kind of Pipe AC

Size 6"

Size of Main 8"

Repair—Renewal—New Service


Location

| Date | Material | Amount | Total | Date | Amount |
|-------------------|-----------------------|------------------|----------------------|----------------|--------|
| 8-8-79 | 2' 6" AC @ | 17.00 | = # 34.00 | | |
| | | | | 8-8-79 | |
| | | | | 2' 6" Transite | |
| | | | | 1 6" X 8" Wye | |

DATE _____

TOWN OF LEXINGTON — BOARD OF PUBLIC WORKS
SEWER DIVISION

Sketch of Service Here

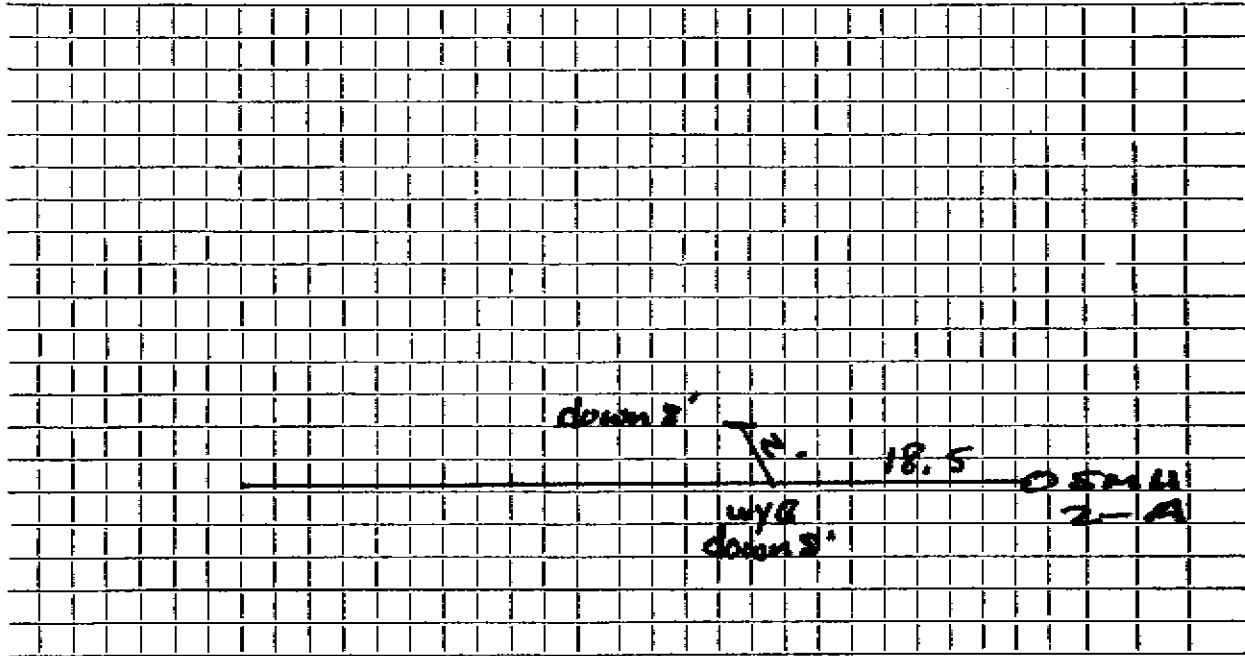

Connection made in Patricia Terrace Street. Work completed

Remarks:
.....
.....