


TOWN OF LEXINGTON — BOARD OF PUBLIC WORKS
SEWER DIVISION

Sketch of Service Here

2

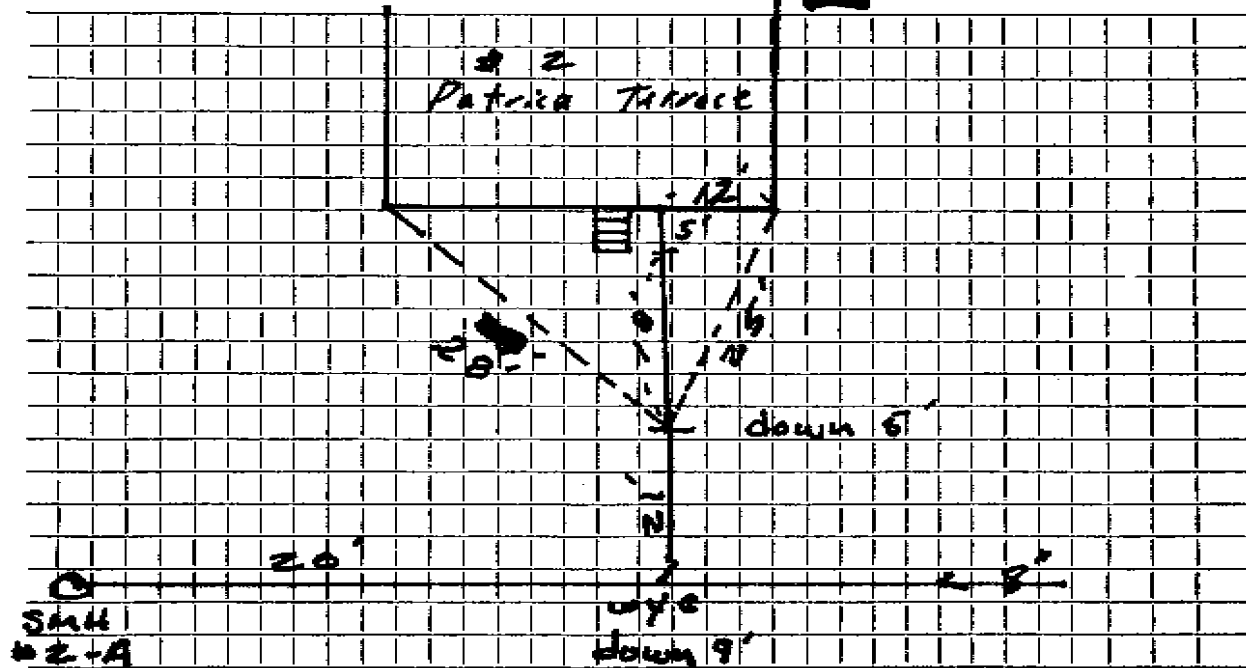

Connection made in Patricia Terrace Street. Work completed

Remarks: