

Name

Service No.

Address 46 THESDA WAY, ARLINGTON

46 Thesda Way

Location

Kind of Pipe

Size 6"

Size of Main 8"

Repair—Renewal—New Service


Location

Date	Material	Amount	Total	Date	Amount
<del>5/7/80</del>	<del>see file</del>	\$15.00	\$300.00	5-7-80	
				20'	6" Transit
				1	6"X8" Wye

DATE 8/1/80

# TOWN OF LEXINGTON — BOARD OF PUBLIC WORKS SEWER DIVISION

Sketch of Service Here **46**

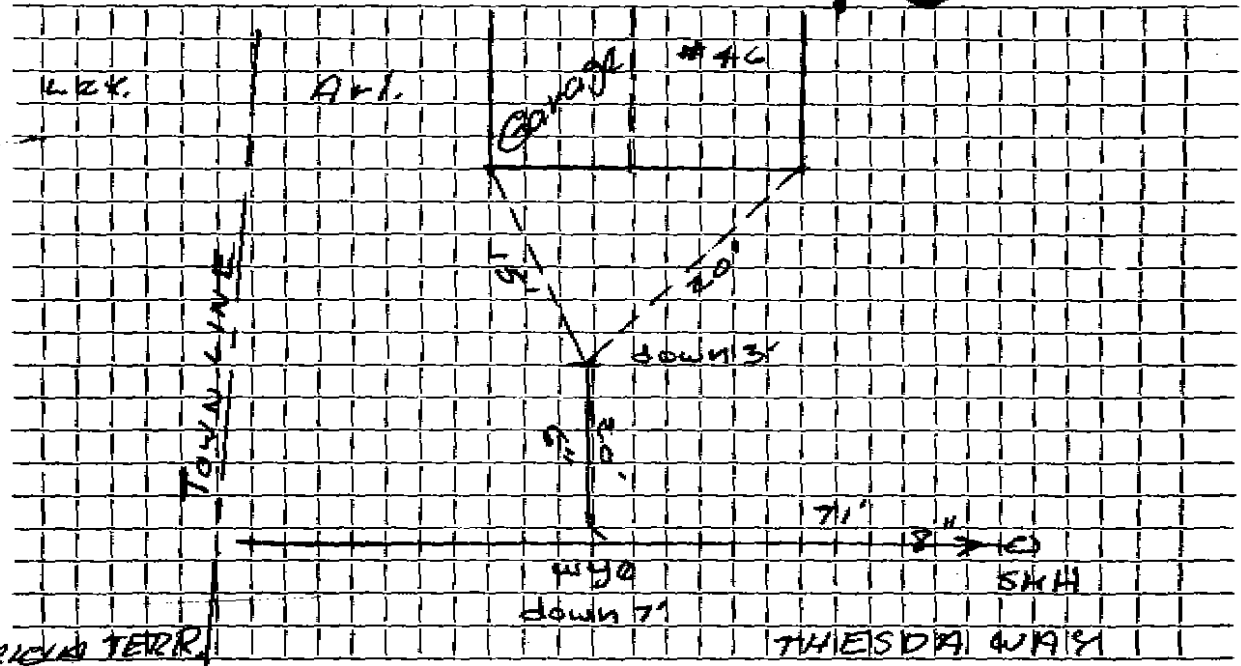

Connection made in THESDA WAY Street. Work completed .....

Remarks: .....  
.....  
.....