




TOWN OF LEXINGTON — BOARD OF PUBLIC WORKS

SEWER DIVISION

Sketch of Service Here

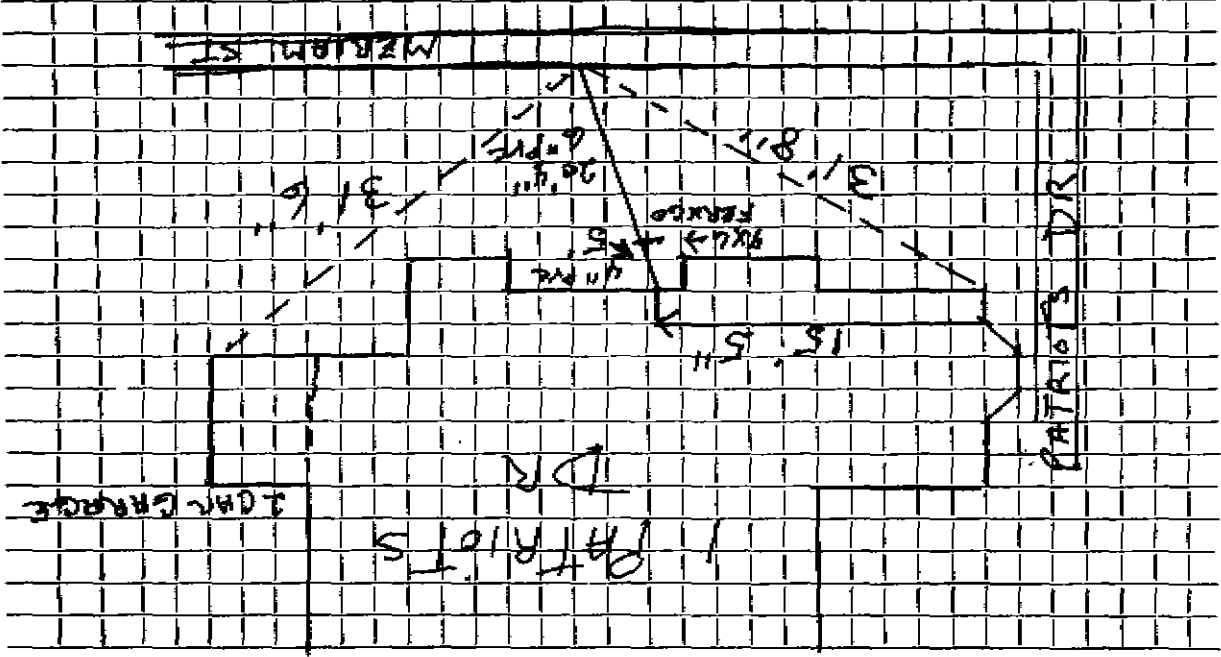

Connection made in MARIAM Street. Work completed JULY 2001

Remarks: INSTALLED BY J.M. McLAUGHLIN

DATE JULY 2001