

Hall & C. Blake

Address 88 Meriam St., Lexington of 874 Washington St., Boston  
17 Patriots Drive Location 4 Blake Avenue 17 Patriots Drive

Kind of Pipe \_\_\_\_\_ Size \_\_\_\_\_ Size of Main \_\_\_\_\_

Repaired Sewer Pipe - New Service

Date	Material	Amount	Total	Date	Location	Amount
Aug. 19 <small>Spec. 6163 &amp; Revised 9/1/36</small>	16 hrs. Labor @50¢	8 00				
	41 " " @55¢	22 55		Aug. 19 1935 - dismounted		90 00
	10 " " @65¢	6 50		Sept 7, 1935 - Rghanded		28 37
	10% Ovhd. on Labor	3 70				61 63
	68' 6" Sewer Pipe @.16	10 88				
	4 hrs. Compressor @2.50	10 00	61 63			
	Labor					

Note: \$ 25.26 of refund - meter payable to  
Town of Lexington, Water Dept. will credits  
to water service # 36 AD

TOWN OF LEXINGTON—BOARD OF PUBLIC WORKS  
SEWER DIVISION

DATE \_\_\_\_\_


17 Patriots Drive NO. \_\_\_\_\_

The undersigned applies for the construction of a particular sewer connecting No. 4 Blake Avenue Street and hereby agrees to comply with the Rules and Regulations governing the construction and use of Particular Sewers, as now or at any future time established by the Board of Selectmen.

Am't. of Estimate \$ \_\_\_\_\_

Am't. Paid \$ \_\_\_\_\_

James Beane Owner

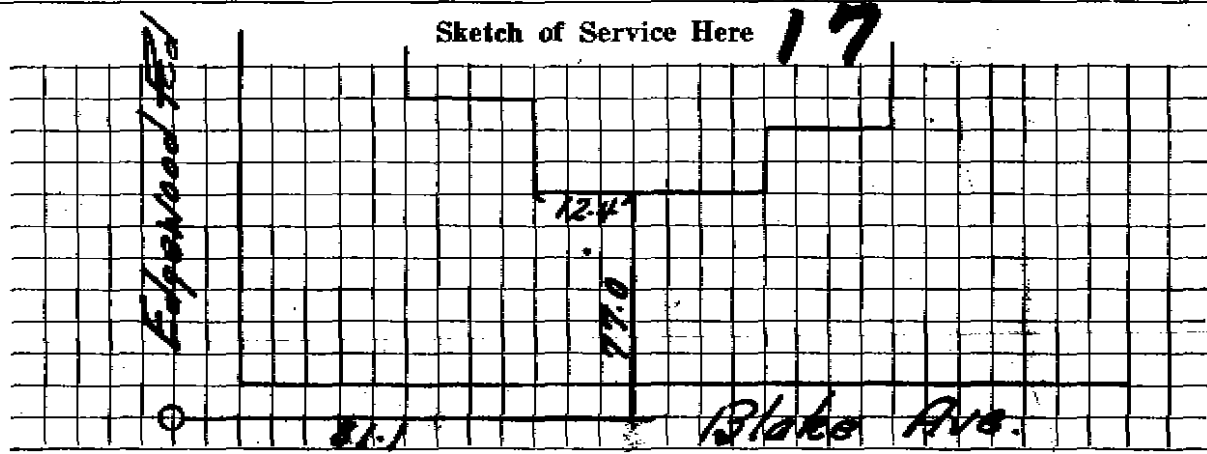

Connection made in \_\_\_\_\_ Street. Work completed \_\_\_\_\_ 19

Remarks: