


DATE 4/3/96

TOWN OF LEXINGTON — BOARD OF PUBLIC WORKS
SEWER DIVISION

Sketch of Service Here **2**

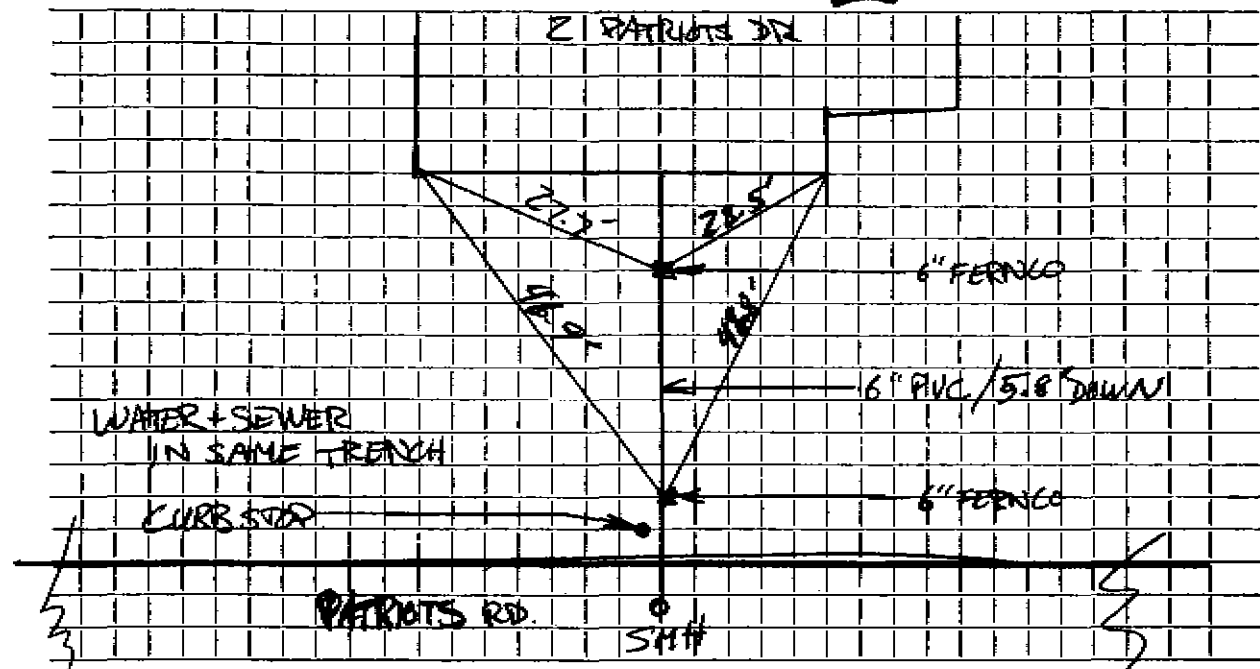

Connection made in Street. Work completed

Remarks: ORIGINAL... Service 11-2-96 (46'-6" Sewer Pipe)