

Name **Lillian Pickering**

Service No. **5**

Address **3 Patriots Drive**

**3 Patriots Drive**

Location **3 Patriots Drive**

Kind of Pipe

Size **6"**

Size of Main **8"**

~~XXXXXXXXXXXX~~ **New Service**

*Com. 5/28/51*

Location

Date	Material	Amount	Total	Date	Amount
3/15/51	Labor	16 33	16 33	3-5-51	Deposited \$100.00
	10% Overhead		1 63	8-2-51	Refunded (25.34)
	50'-6" Sewer Pipe @ .344		17 20		74 66
	Joint Compound		3 00		
	5 Hrs. Littlefield Shovel @ 7.		35 00		
	2 Hrs. Trucking		1 50		
			<u>74 66</u>		
	<b>Labor</b>				
	<b>(Service was in to curb - No charge)</b>				

TOWN OF LEXINGTON—DEPT. OF PUBLIC WORKS  
SEWER DIVISION

DATE .....

NO. ....


The undersigned applies for the construction of a particular sewer connecting No. ....  
Street and hereby agrees to comply with the Rules and Regulations governing the construction and use of Particular  
Sewers, as now or at any future time established by the Board of Selectmen.

Am't of estimate \$.....

Am't Paid \$.....

..... Owner

Sketch of Service Here

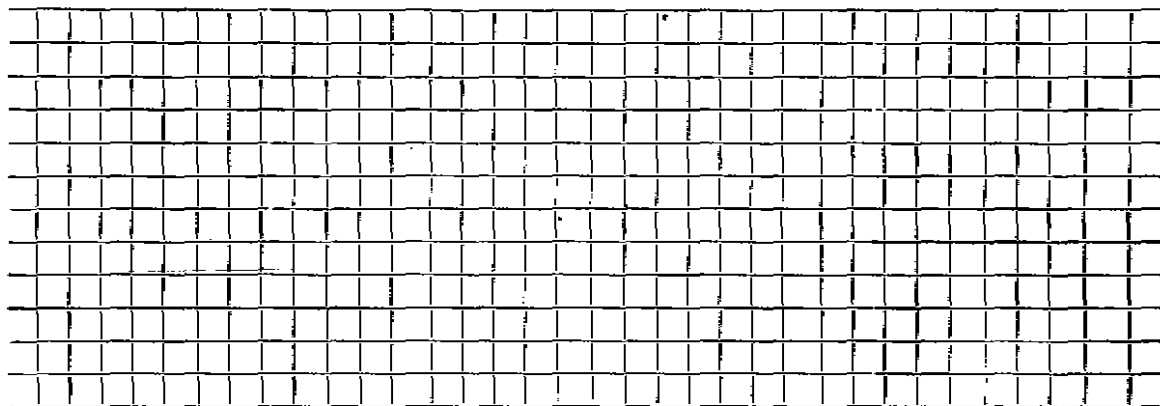

Connection made in ..... Street.

Work completed ..... 19..

Remarks: *Original Service 6-25-48 (66'-6" sewer Pipe, 1-6"  $\frac{1}{8}$ " Bond)*