

Address 4 Oakmount Circle

Location #0 Patriot's Drive

Kind of Pipe

Size

Size of Main

Material

Location

Date	Amount	Total	Date	Amount
6/18/37	6.50		11-3-37	96.44
12 hrs. @ 50¢ filled by	14.30			
20 hrs. @ 55¢ permission on	17.40	46.50 ✓		
28 " @ 60¢	8.40	4.56 ✓		
12 " @ 70¢		7.00 ✓		
10 1/2 Overhead		1.58 ✓		
28' 8" Sewer Pipe @ 25¢		6.00 ✓		
Jointing Compound		1.30 ✓		
2 hrs. Compressor @ 3.00		3.00 ✓		
2 " Trucking @ .75		\$ 70.44		
1 hr. Tractor @ 3.00		26.00		
Trench Repairs:		\$ 96.44		
Labor				
			1-22-67	Heavy Materials

Recd amt 10/30/37

TOWN OF LEXINGTON—BOARD OF PUBLIC WORKS  
SEWER DIVISION

DATE \_\_\_\_\_

NO. \_\_\_\_\_


The undersigned applies for the construction of a particular sewer connecting No. 6 Patriots' Drive Street and hereby agrees to comply with the Rules and Regulations governing the construction and use of Particular Sewers, as now or at any future time established by the Board of Selectmen.

Am't. of Estimate \$ \_\_\_\_\_

Am't. Paid \$ \_\_\_\_\_

Robert G. Morrison Owner

Sketch of Service Here

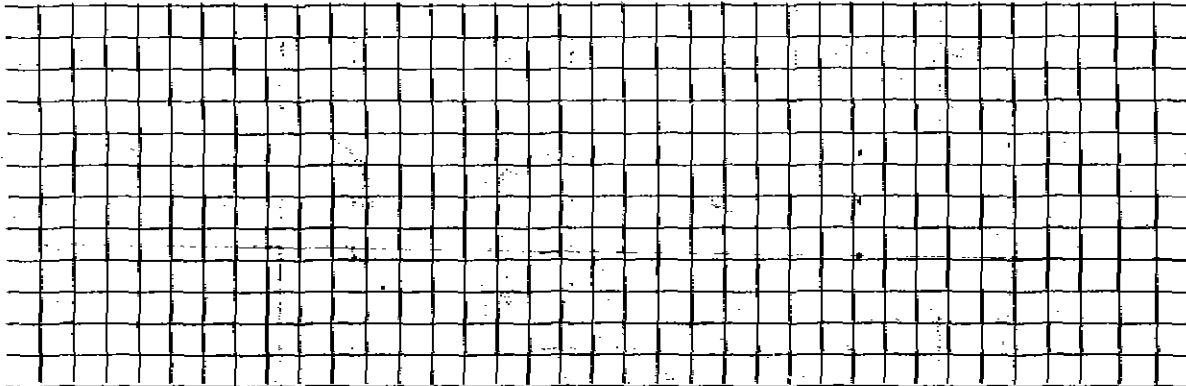

Connection made in \_\_\_\_\_ Street.

Work completed \_\_\_\_\_ 19

Remarks: