


DATE MAY 9, 1997

TOWN OF LEXINGTON — BOARD OF PUBLIC WORKS
SEWER DIVISION

Sketch of Service Here

8

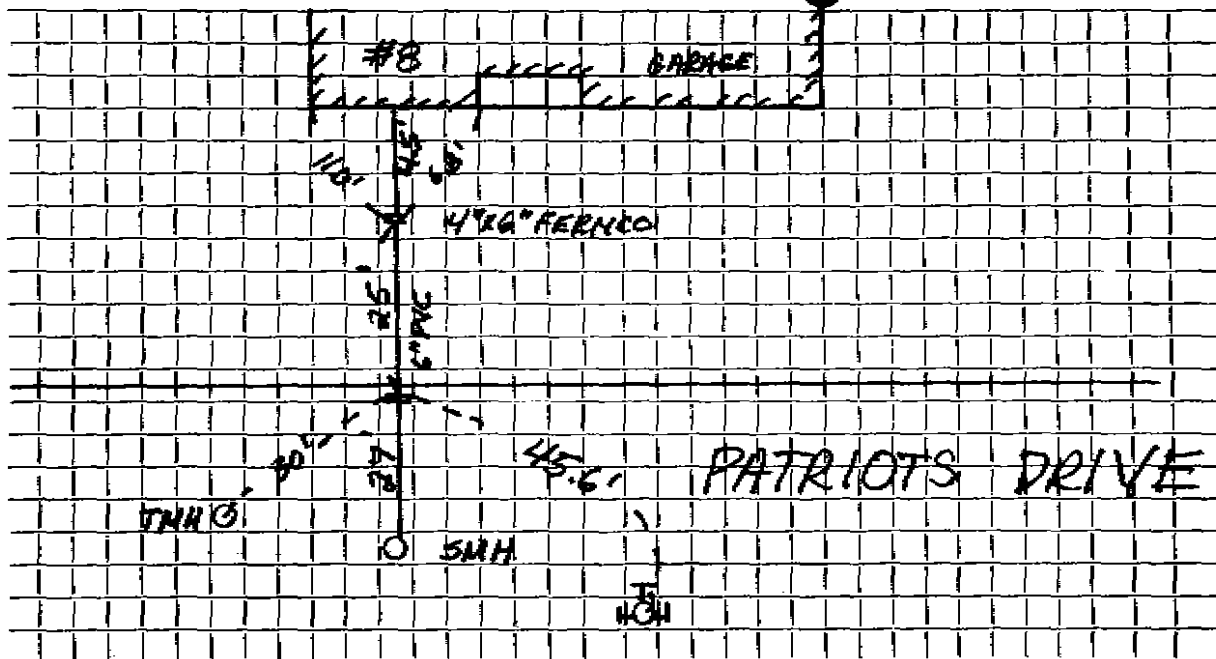

Connection made in PATRIOTS DRIVE Street.

Work completed RHINO CONSTRUCTION

Remarks:

BOOK 96-5 & BOOK 97-1

J.W.