

Name Mrs. Harry C. Gates

Service No. 246

Address 11 Patterson Road

11 Patter son Road

Location

Kind of Pipe

Size 6"

Size of Main 8"


~~Replaced~~ New ServiceLocation *Cond 2-29-60*

Date	Material	Amount	Total	Date	Amount	
17-59	Labor	69.13		11-30-59	Deposit	250.00
18-59	"	15.38	84.51	2-29-60	Retained	47.25
	10% O.H.	8.45	92.96			202.25
70'	6" Transite pipe @.70		49.00		NON CHARGE	
1	6" Transite Adapter		1.90	12-18-59	Labor	14.50
1	6" 90° Transite Elbow		5.29		(wait for Shovel)	
1	6" 11 1/2° Transite Band		5.10			
4	hrs. dippin shovel @4.50		18.00			
4	hrs. Trucking @.75		3.00			
2	hrs. Town Shovel @6.50		13.00			
14	x 3 Patch		14.00			
			202.25			

DATE _____

TOWN OF LEXINGTON — BOARD OF PUBLIC WORKS
SEWER DIVISION

Sketch of Service Here

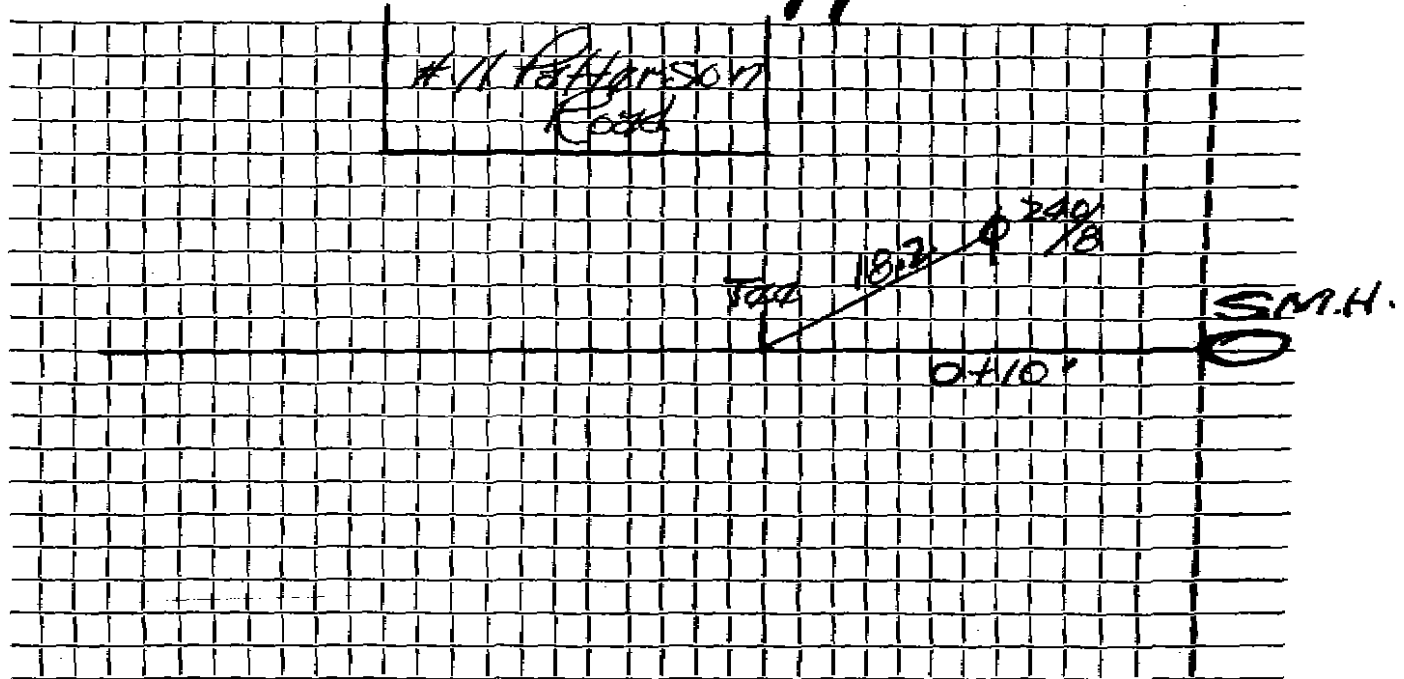

Connection made in Street. Work completed

Remarks:

.....

.....