

Name

Kenneth Cevay

Service No. 60

Address

17 Patterson Road

17 Patterson Road

Location

Kind of Pipe

Size 6"

Size of Main 8"

~~Residential~~ New ServiceSuburbanite #1404
W.O. # 6610

Location SEP 2 1969

Date	Material	Amount	Total	Date	Amount
6/6/69	Labor	80 9/4		6-30-69	Deposit 260 00
	"	10 88	91 82	9-3-69	Retard 85 23
	10% O.H.		9 18	7-16-69	164 27
231	Transite Pipe .88		20 24	23'	6" Transite
2	Bends 4.09		8 18	2	6" Bends
2	Ton Hot Top 5.80		11 60		
2	Hrs. Trucking 3.00		6 00		
1/2	" " 1.50		75		
2	" Shovel 6.50		13 00		
1/2	" Roller 3.00		1 50		
	Trailer		2 00		
			164 27		
18-69 27	6" Transite				
10	4" Cast Iron pipe				


DATE _____

TOWN OF LEXINGTON — BOARD OF PUBLIC WORKS

SEWER DIVISION

Sketch of Service Here

17 S.S. Form # 17

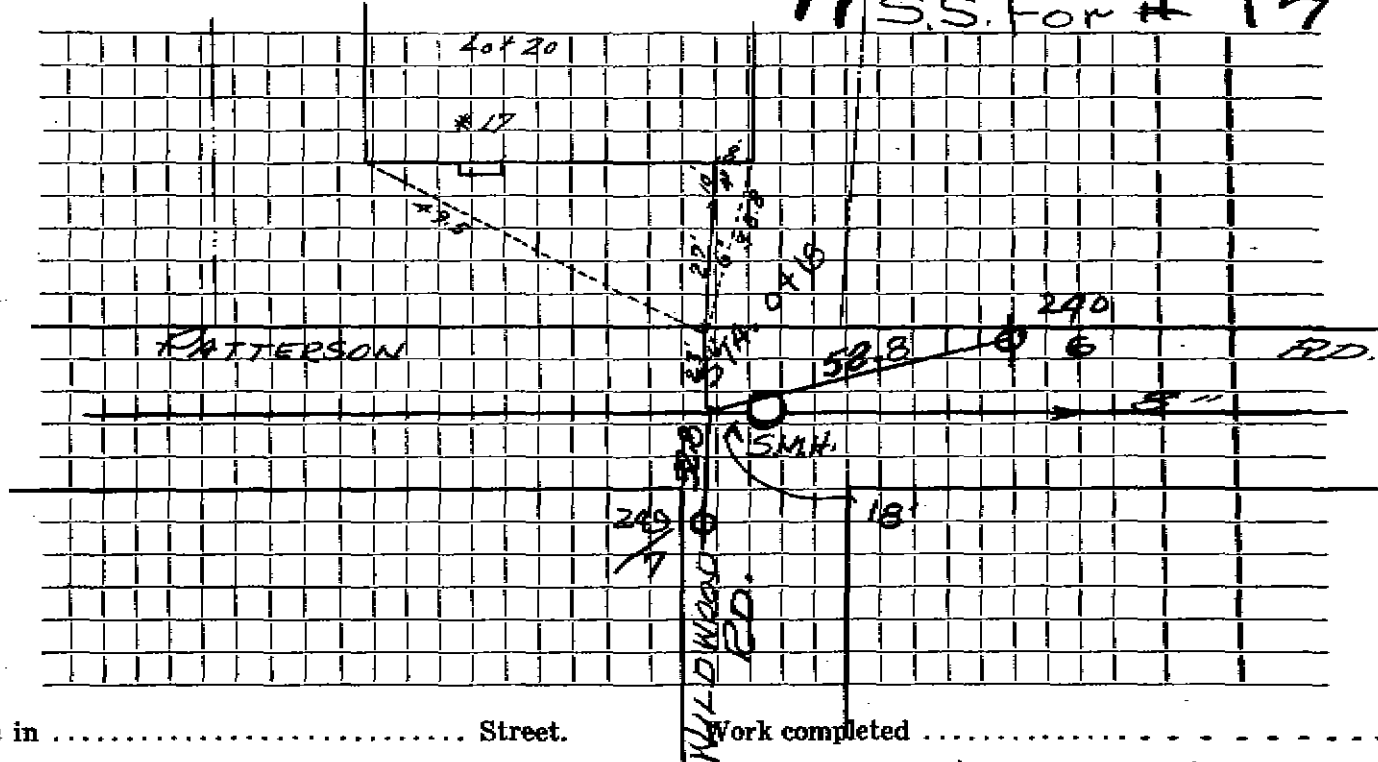

Connection made in Street.

Work completed

Remarks:
.....
.....