

Name **Donald D. Ranney**

Service No. 249

Address **18 Patterson Road**

8 Patterson Road

Location

Kind of Pipe

Size **6"**

Size of Main **8"**

~~REWORK~~ **New Service W.O. #1396**

Valeri Const Co Permit #1147

Location

JUN 27 1966

Date	Material	Amount	Total	Date	Amount
-65	Labor 52.02			12-6-65	Deposit 125 00
-66	Patching 4.57	56 59		7-5-66	Paid 2 06
	10% O.H.	5 66	62 25	12-9-65	
		52 25			
20'	6" Transite Pipe @ .80		16 00	20' 6" Transite	
1	90° Elbow		4 09	1 6"-90° Elbow	
	1/4 x 1/4 Patch		18 67	1 6"x8" Wye	
1	Yard Loan		3 00		
1	Lb Grass seed		1 05		
2	Hrs - Tractor @ 6.50		13 00		
3	Hrs - Truck @ 3.00		9 00		
			127 06		
55	56' 6" Transite pipe				
					Bill sent 206


DATE _____

TOWN OF LEXINGTON — BOARD OF PUBLIC WORKS

SEWER DIVISION

Sketch of Service Here

18

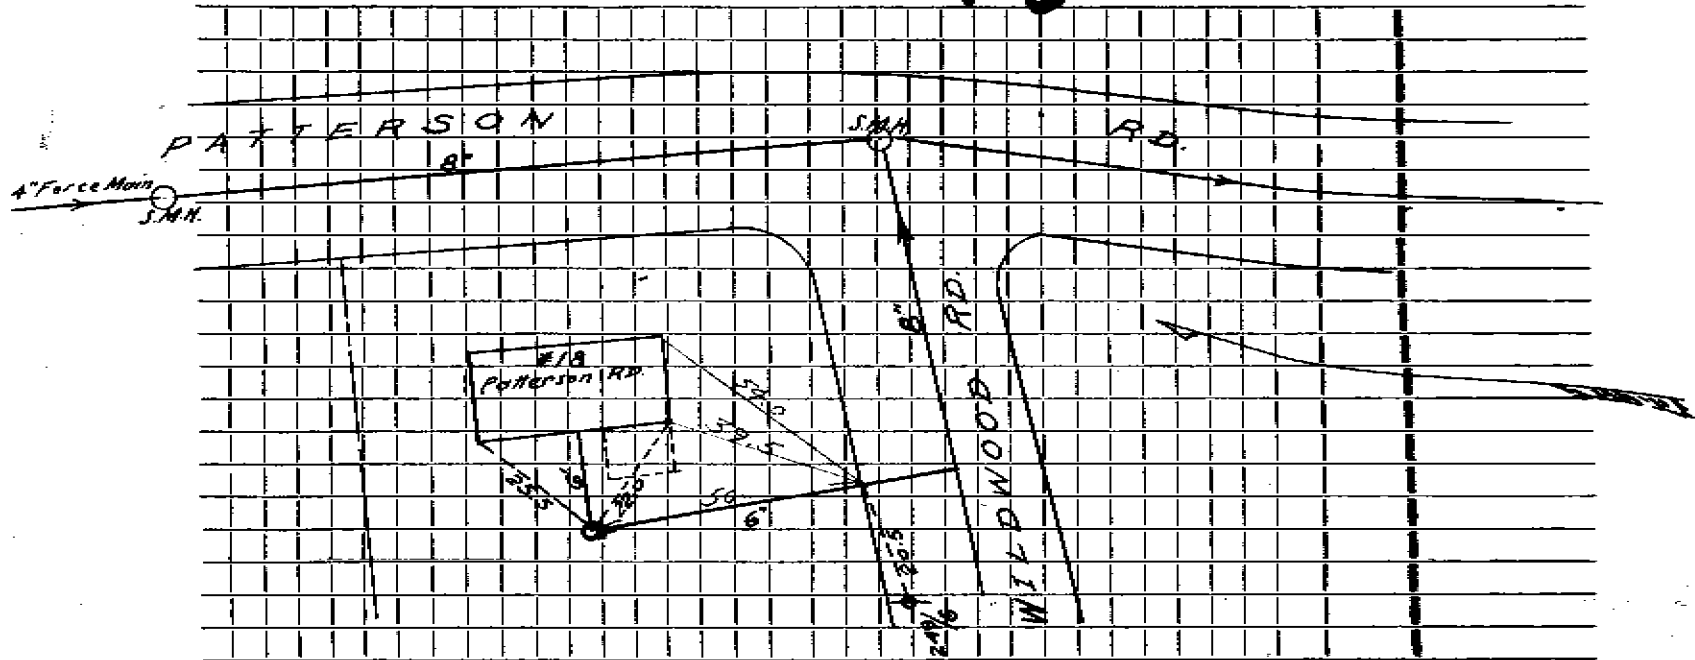

Connection made in Street. Work completed

Remarks:
.....
.....