

Name Louis Gilbert

Service No. 164

Address 19 Patterson Road

19 Patterson Road

Location

Kind of Pipe Suburbanite Cesspool-Permit #129

Size 6"

Size of Main 8"

Remarks ~~UNKNOWN~~ - New Service W.O. #9289

Location FEB 15 1965

Date	Material	Amount	Total	Date	Amount
19-64	Labor	18.72		16-9-64	Deposit 150 00
20-64	Labor	32.72	51 14	2-15-65	Retund 29 00
	10% O.H.	5 14	56 58	10-19-64	121 00
20'	6" Transite pipe @ .82		16 40	20' 6" Transite	
1	90° Elbow		1 09	1 6"-90° Elbow	
1	End cap		1 93		
	20 x 3 Patch		20 00		
2	Hr. Town Shovel @ 6.50		13 00		
2	Hr. Town Truck @ 3.00		6 00		
1	Hr. Trailer		3 00		
			121 00		
29-64	80' 6" A.C. Transite pipe				


DATE \_\_\_\_\_

TOWN OF LEXINGTON — BOARD OF PUBLIC WORKS

SEWER DIVISION

Sketch of Service Here

19 S.S. For # 19

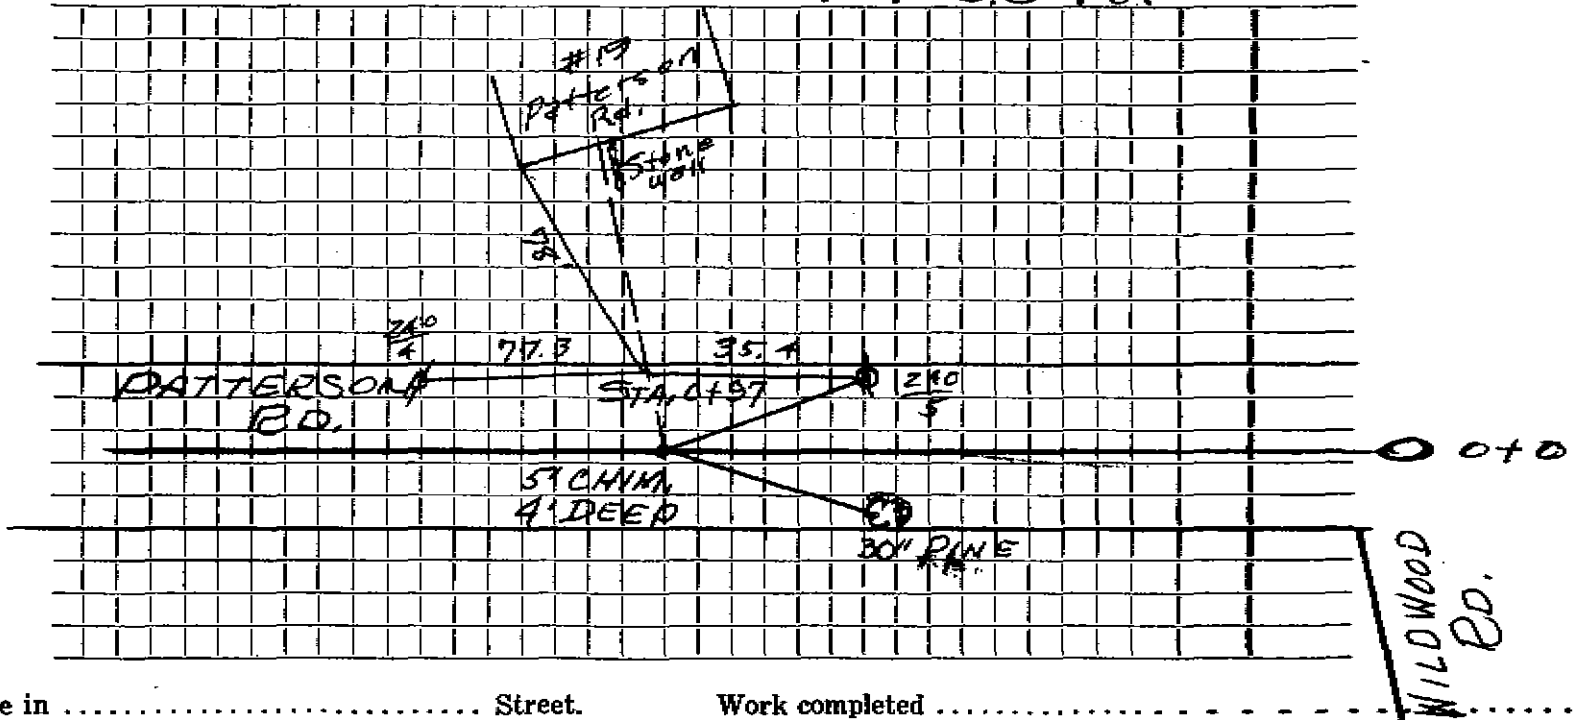

Connection made in ..... Street. Work completed .....

Remarks: .....

.....

.....