


DATE 9/10/12

TOWN OF LEXINGTON — BOARD OF PUBLIC WORKS
SEWER DIVISION

Sketch of Service Here

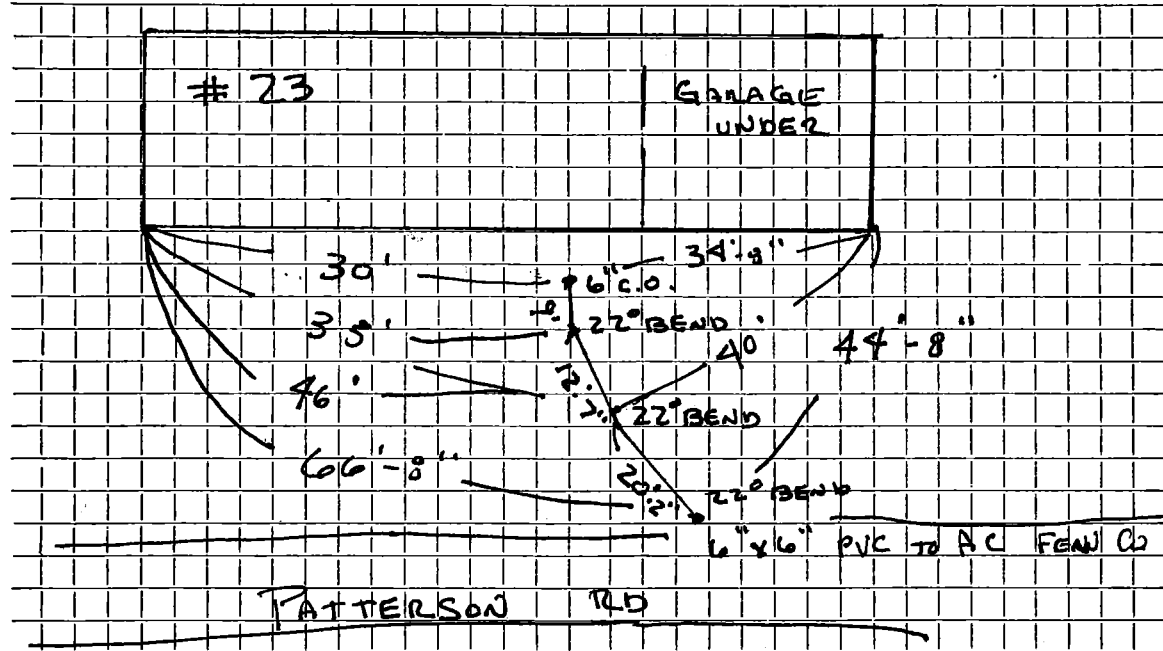

Connection made in Street. Work completed

Remarks: TOTAL LENGTH of 6" PVC 41'-9"

COVER = 3'-6" AT STREET

COVER = 5'-0 AT BLDG