

Name

Service No. 4344

Address

26 Patterson Rd

Location

Kind of Pipe

PVC + AC

Size

6"

Size of Main

Repair—Renewal—New Service


J. McLaughlin

Location Pg. 59-10T 100

Date	Material	Amount	Total	Date	Amount
10/29/11	3' 4" Sch 40				
	1 4" Clean OUT @ house				
	1 1" Sch 40				
	1 4x6 Fernco				
	1 6" - 22° bend				
	64' 6" PVC				
	1 6" - 45° bend				
	4' 6" PVC				
	1 6" PVC X AC Fernco 9' down				
	Existing				
5/11/71	1 6" CHIM. / 8' deep				
	1 6x6 nipple				
	1 6" - 90° Elbow				
	22' 6" Transite Pipe				

TOWN OF LEXINGTON — BOARD OF PUBLIC WORKS
SEWER DIVISION

Sketch of Service Here

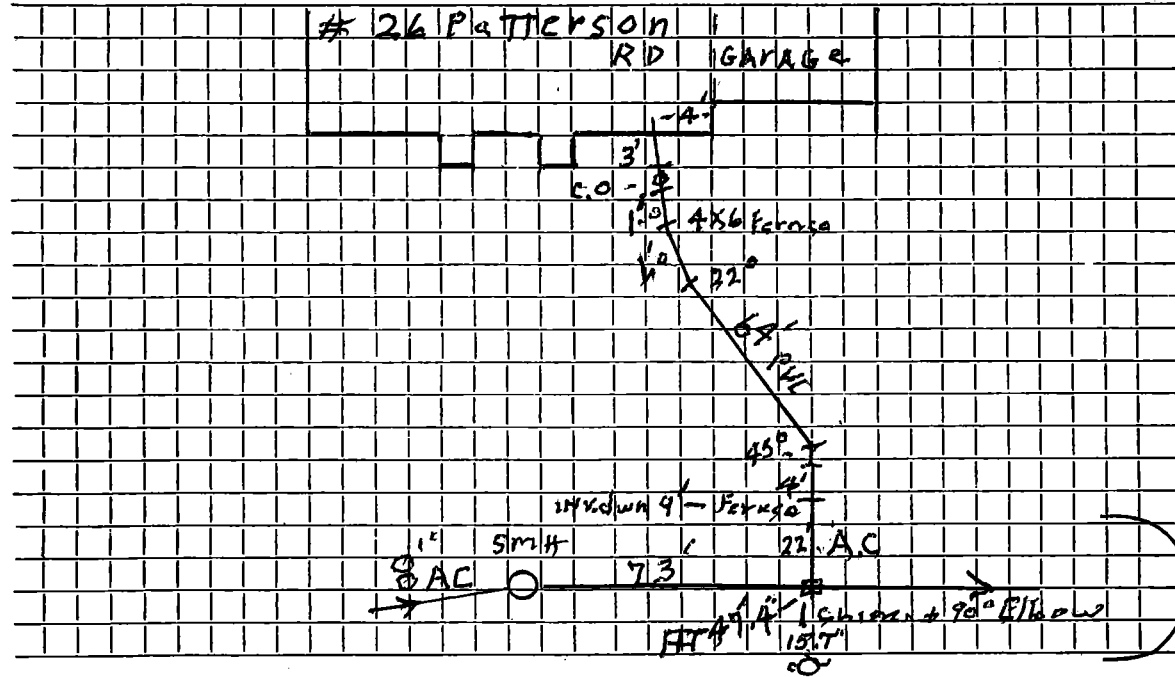

Connection made in Street. Work completed

Remarks: 6" Chim. 8' deep / 6" Nipple + 90° Elbow

.....
.....