

Name Jason M. Cortell

Service No. 37

Address 27 Patterson Road

27 Patterson Road

Location

Kind of Pipe

Size 6"

Size of Main 8"

New Service John Devine Permit #A225 - W.O.#2070

Location


JUN 27 1966

Date	Material	Amount	Total	Date	Amount
7-66	Labor 105.28			4-11-66	Deposit 175.00
9-66	Patching 50.09	155 37		10-27-66	Taid 81.00
	10% O.H.	15 54	170 91	4-27-66	256 00
181	6" Transite pipe @ 82		24 76	18	6" Transite
3	90° Elbow		4 09	1	6"-90° Elbow
1	6" Nipple		91	1	6" Nipple
1	Adapter		1 08		
1	Ton cold patch		5 00		
3	Ton hot top @ 5.50		16 50		
4 1/2	Hrs. Truck @ 3.00		13 50		
3	Hrs. Shovel @ 6.50		19 50		
1	Hr. Compressor @ 5.00		5 00		
1/2	Hr. Tractor @ 6.50		3 25		
1/2	Hr. Roller @ 3.00		1 50		
			256 00		
-66	84' 6" Cast Iron Pipe				Billament 81.00

DATE _____

TOWN OF LEXINGTON — BOARD OF PUBLIC WORKS
SEWER DIVISION

Sketch of Service Here **27** S.S. For # 27

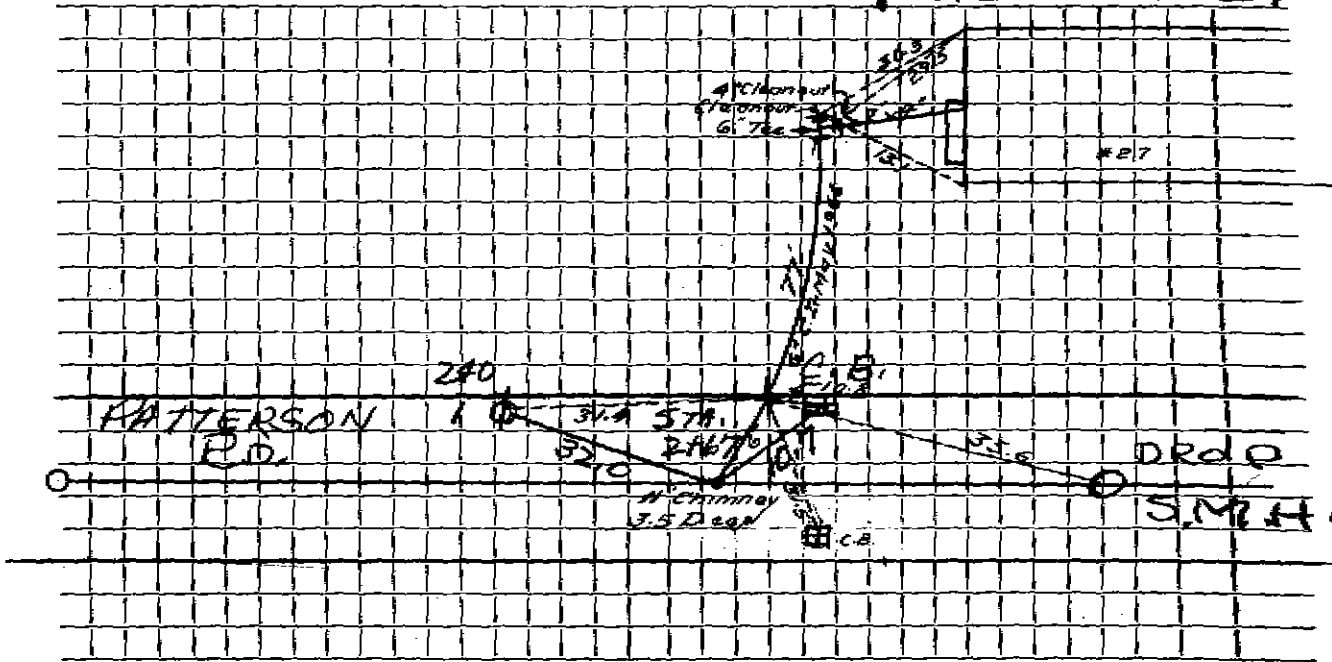

Connection made in Street. Work completed

Remarks:

.....

.....