


TOWN OF LEXINGTON — BOARD OF PUBLIC WORKS
 SEWER DIVISION

Sketch of Service Here **3** ST For # 3

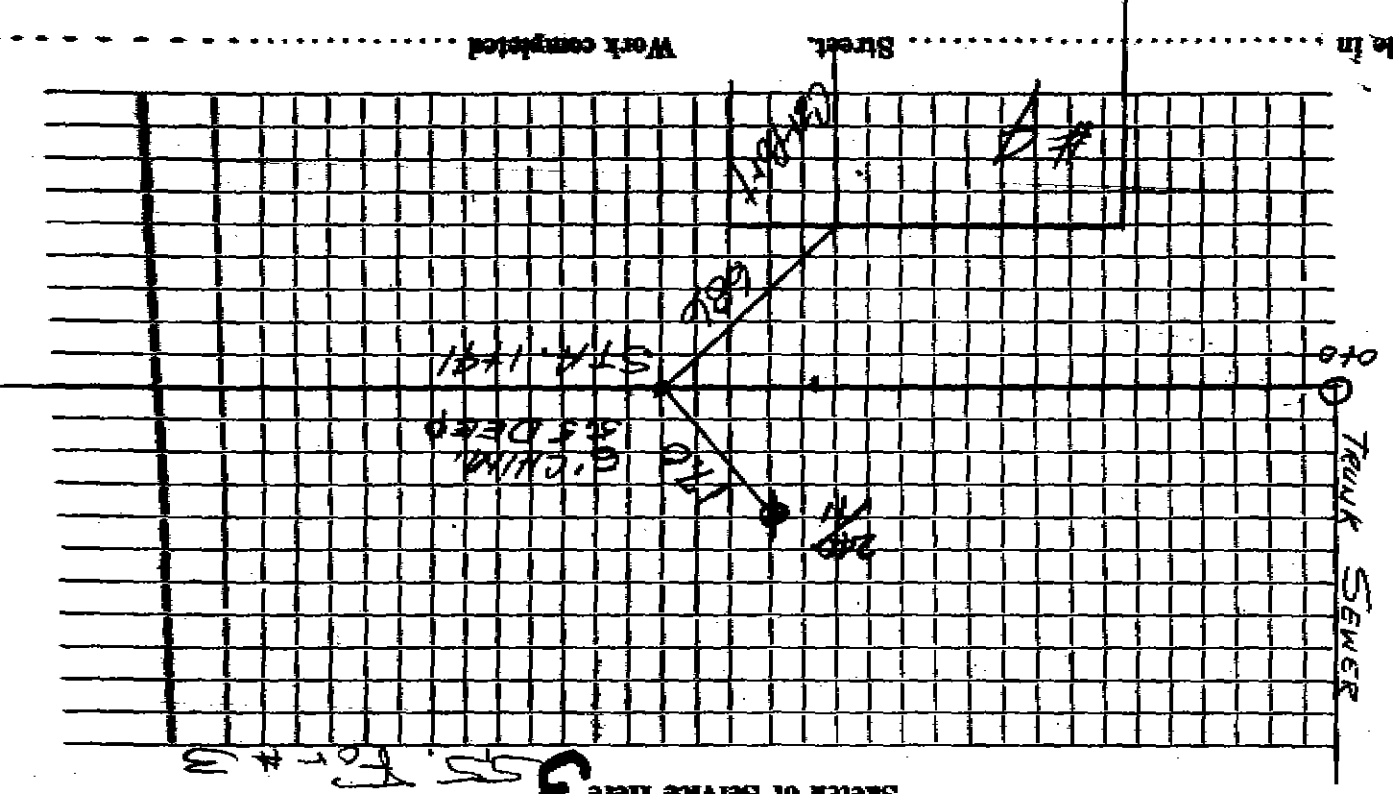

Connection made in
 Remarks:

Street
 Work completed