


DATE _____

TOWN OF LEXINGTON — BOARD OF PUBLIC WORKS

SEWER DIVISION

Sketch of Service Here

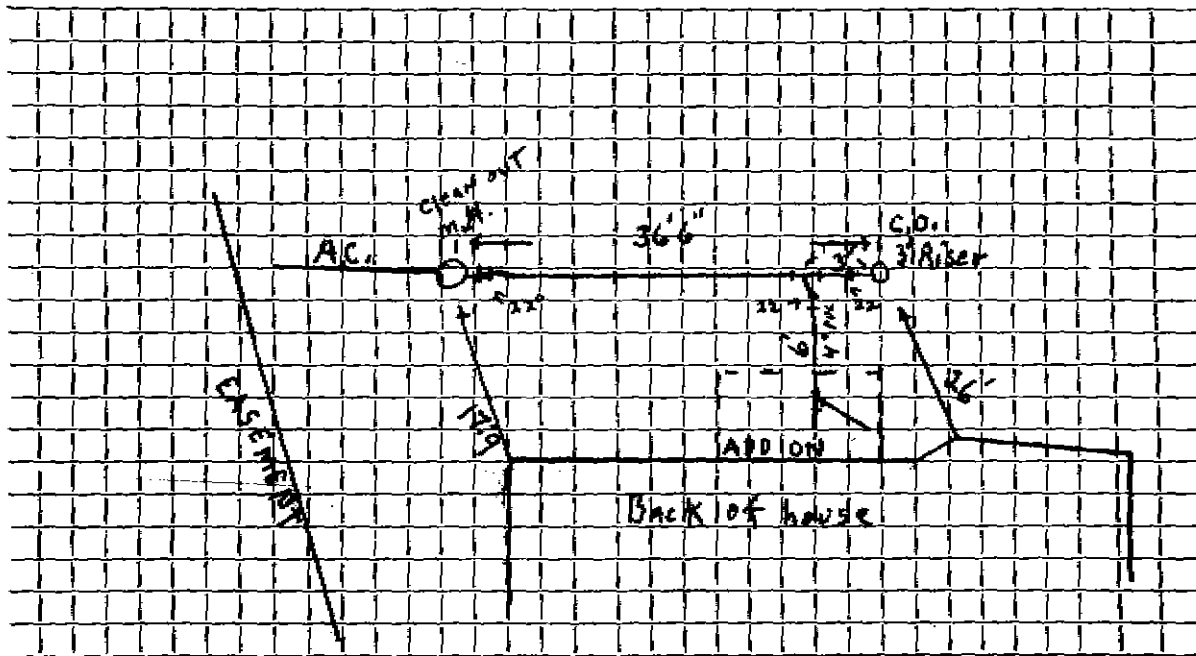

Connection made in Street. Work completed

Remarks: Original Service 11-7-66 (30'-6" Transite, 2'-6"-1 1/2° Elbow, 1'-6"-
1 1/2° Bend)

Name Robert Benzaquin

Service No. 138

Address 32 Patterson Road

Location

Kind of Pipe

Size

Size of Main

Repair—Renewal—New Service

Location O. m. m. 2-12-67

Date	Material	Amount	Total	Date	Amount
7/66	Labor 101.20			10-28-66	200 00
3/66	" 12.20			8-21-67	131 26
29/66	" 58.48	171.88			321 26
	10% O.H.	17.39	189 07		
30'	6" Transite Pipe		26.40		
2	11 1/2" Transite Elbow		4 70		
1	11 1/2" Transite Bend		4 09		
1	Yd. Loam		3 00		
3	Ton Hot Top @5.50		16 50		
6	Hrs. Town Shovel		39 00		
3	Hrs. Loader		12 00		
7	Hrs. Trucking		21 00		
1	Hr. Roller		3 00		
1/2	Hr. Compressor		2 50		
			321 26		

DATE _____


TOWN OF LEXINGTON — BOARD OF PUBLIC WORKS

SEWER DIVISION

Sketch of Service Here

SS. For # 32

NOTE
Tap @ 13
From PUMP STA.
For House # 30

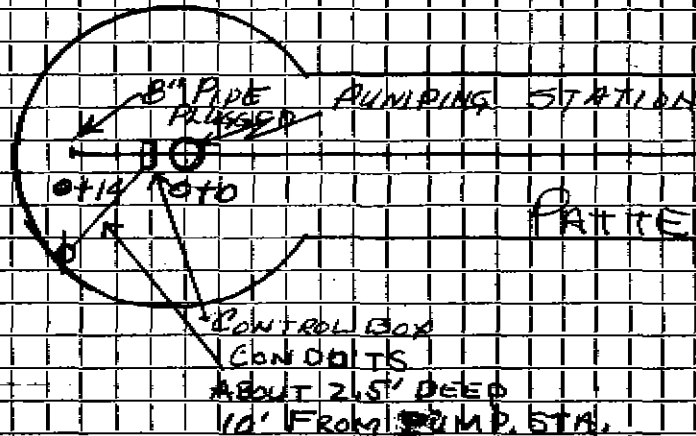

PATTERSON RD.

Connection made in Street. Work completed

Remarks:

.....

.....