

Name **William J. Melley**

Service No. **16**

Address **4 Patterson Road**

**4 Patterson Road**

Location

Kind of Pipe

Size **6"**

Size of Main **8"**

~~Repair~~ ~~Replacement~~ **New Service**

Location **Conn 5-9-68**

Date	Material	Amount	Total	Date	Amount
<del>11-60</del> <del>12-60</del>	<b>Labor</b>	89.04		3-28-60	200.00
	<b>10% O.H.</b>	8.90	97.94	5-9-60	20.31
40'	<b>6" Transite pipe @.78</b>		31.20		179.69
1	<b>6" 90° Transite Elbow</b>		5.29		
1	<b>11 1/4° Transite Bend</b>		5.10		
1	<b>6" Transite Tee</b>		1.16		
12	<b>x 3 Patch</b>		12.00		
3	<b>hrs. Shovel @6.50</b>		19.50		
1	<b>hr. Trailer @3.00</b>		3.00		
1	<b>hr. Trucking @3.00</b>		3.00		
2	<b>hrs. Trucking @.75</b>		1.50		
			<u>179.69</u>		


DATE \_\_\_\_\_

TOWN OF LEXINGTON — BOARD OF PUBLIC WORKS

SEWER DIVISION

Sketch of Service Here

4

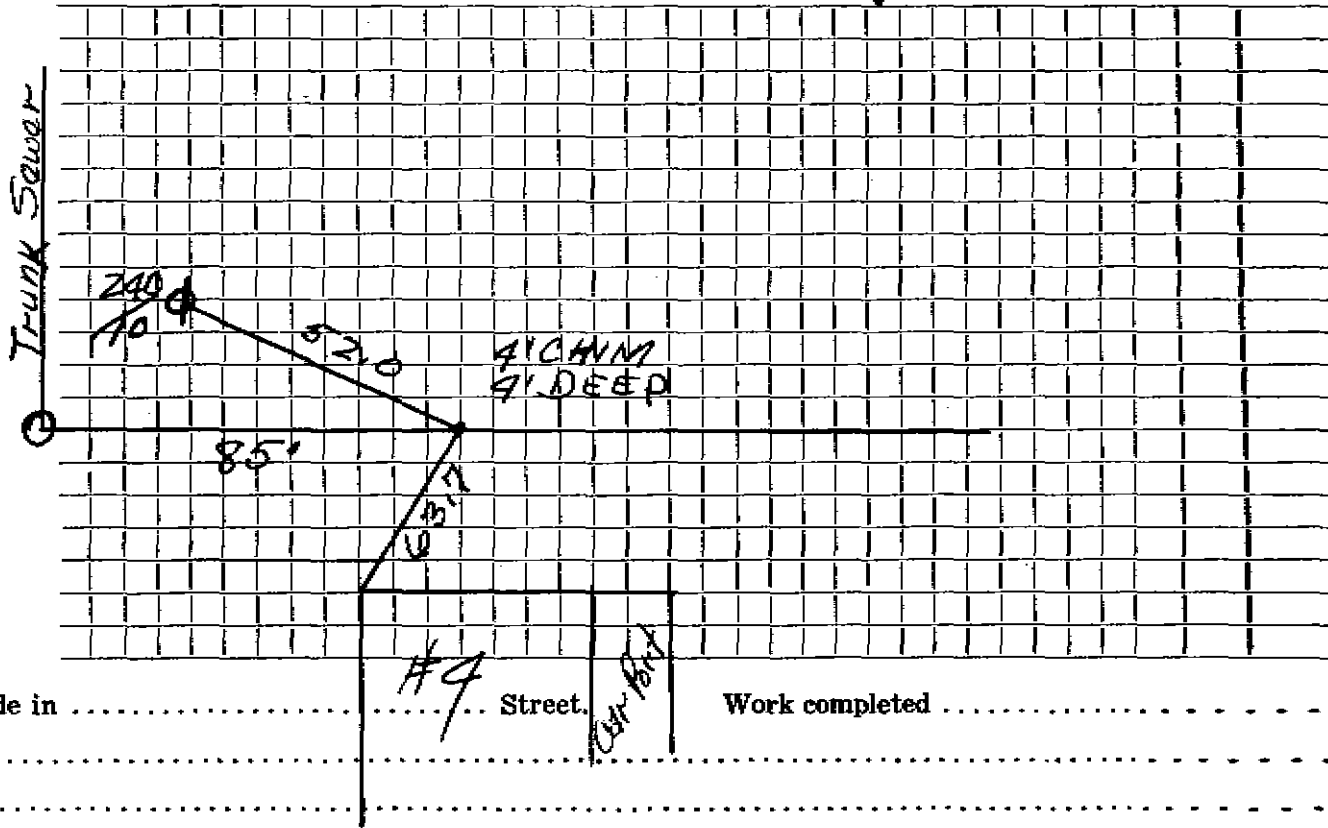

Connection made in ..... Street. Work completed .....

Remarks: .....

.....

.....