

Name **Nickerson, Durso**Service No. **11**Address **5 Patterson Road****5 Patterson Road**

Location

Kind of Pipe

Size **6"**Size of Main **8"**~~NEW SERVICE~~ **New Service**Location **Comm 6-16-60**

Date	Material	Amount	Total	Date	Amount
1-60	Labor	84. 06		3-21-60	Deposit 250.00
2-60	"	129. 22		5-16-60	Paid by agreement 413.60
4-60	"	110. 22			663.60
5-60	"	25. 60			
5-60	"	26. 89			
		375. 99			
	10 % O.H.	37. 60	413. 59		
71'	6" Transite Pipe @ .78		55. 38		
1	Cesspool Cover & Frame		10. 50		
10	Bags cement @ 1.50		15.00		
1500	Sewer Brick 4.20/100		63. 00		
2	Ton Brick Sand @ 1.00		2. 00		
2	6" 450 Transite Elbow @ 2.79		5. 58		
1	6" 450 Clay Elbow		1. 88		
15	1/2 Ton Bank gravel @ .85		13. 17		
20	3 Patch		20. 00		
4	Hrs Town Shovel @ 6.50		26. 00		
6	Hrs Pippin @ 4.50		27. 00		
10	Hrs Trucking @ .75		7. 50		
3	Hrs Pumping @ 1.00		3. 00		
			663. 00		


TOWN OF LEXINGTON — BOARD OF PUBLIC WORKS

SEWER DIVISION

DATE: _____

Sketch of Service Here

5

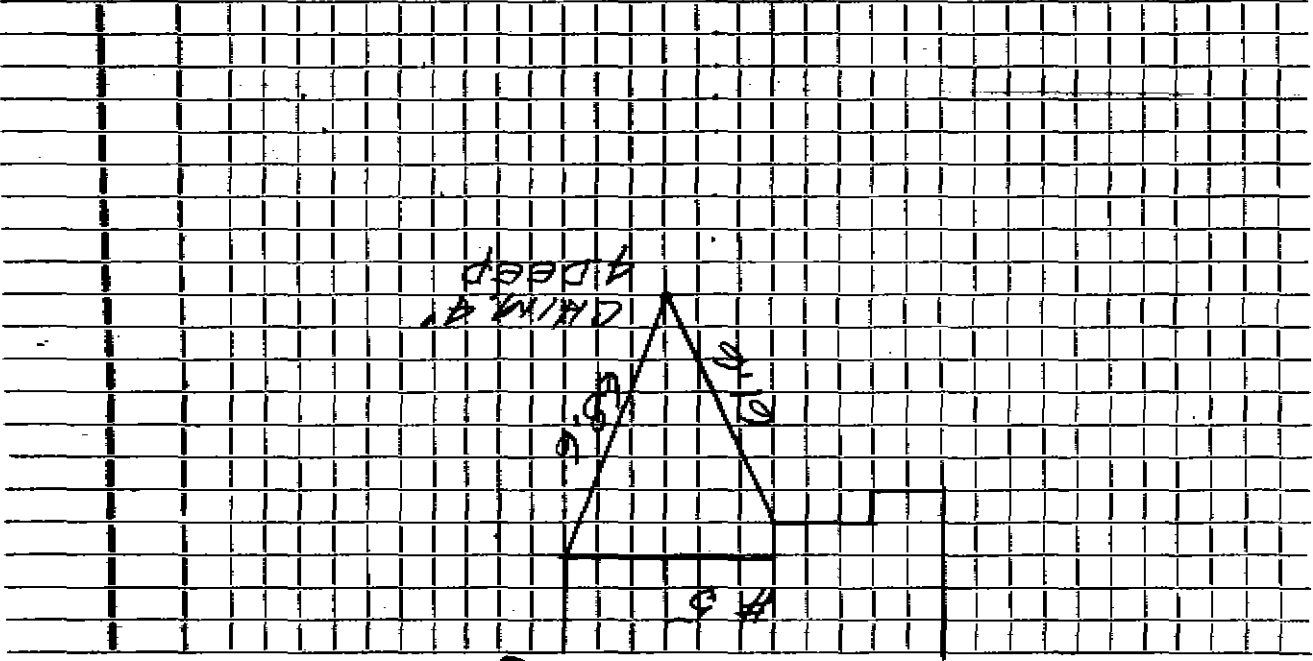

Work completed

Street

Connection made in

Remarks: