

TOWN OF LEXINGTON — BOARD OF PUBLIC WORKS

SEWER DIVISION

DATE _____


Sketch of Service Here

6

55.75 ft + 0

TRUNK SEWER

0 + 0

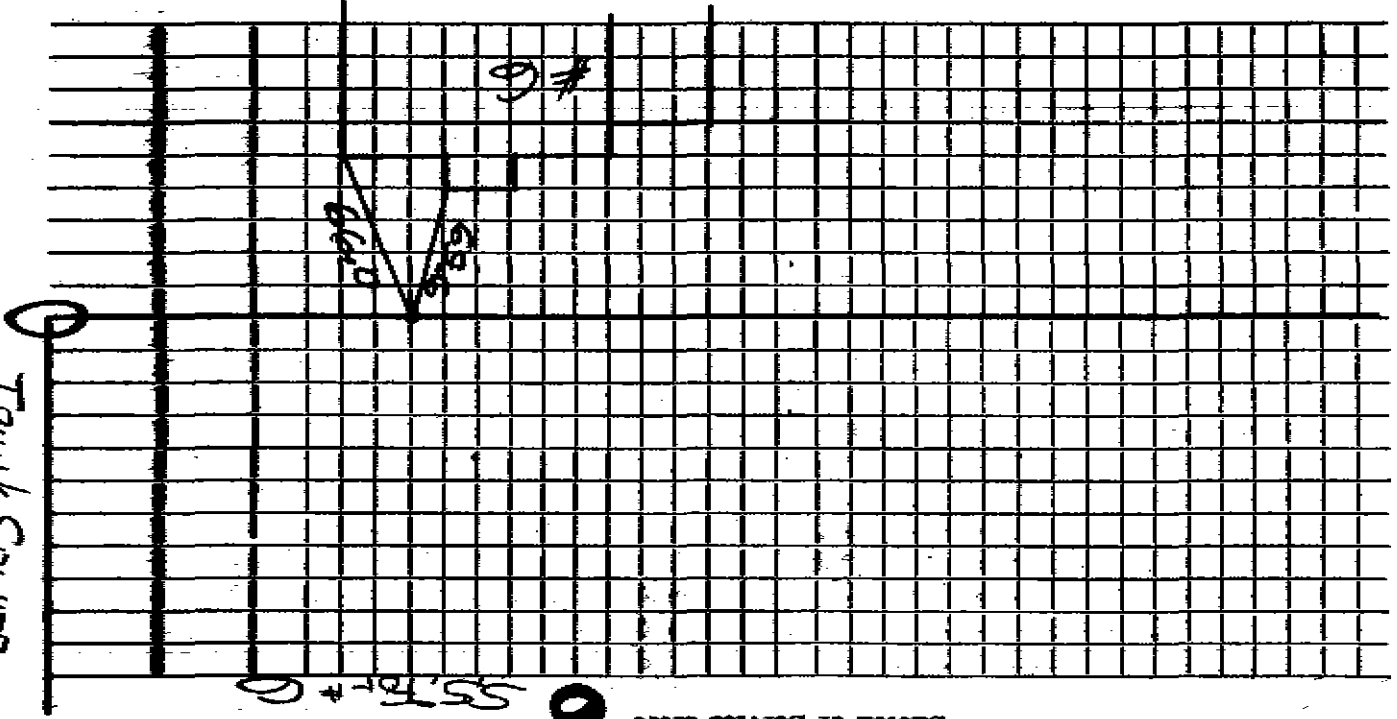

Connection made in _____

Street _____

Work completed _____

Remarks: _____