


TOWN OF LEXINGTON — BOARD OF PUBLIC WORKS

SEWER DIVISION

DATE _____

Sketch of Service Here **8** 55, For # **B**

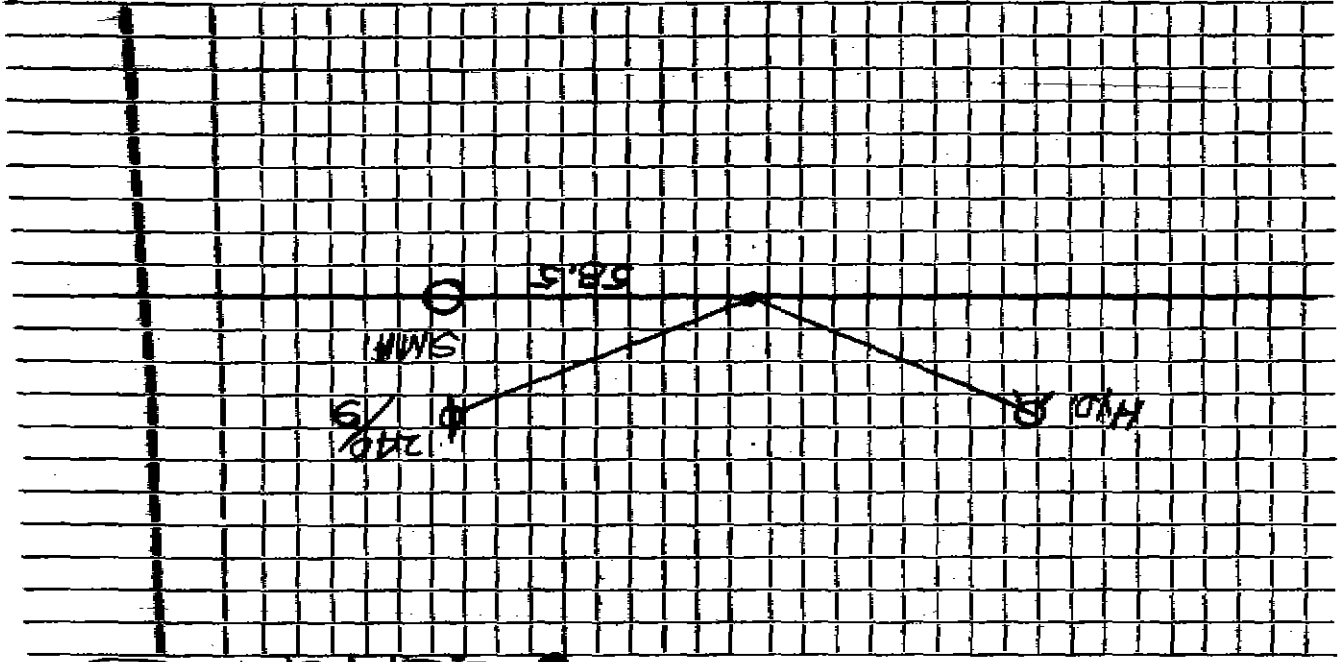

Connection made in _____

Street _____

Work completed _____

Remarks: _____