

Name Roy Moore

Service No. 231

Address 11 Paul Revere Road

11 Paul Revere Road

Location Comm. 3-3-58

Kind of Pipe

Size 6"

Size of Main

~~XXXXXX~~ New Service

Location

Date	Material	Amount	Total	Date	Amount
2-30-57	Labor	72.81		12-18-57	Deposit \$200.00
	10% O.H.	7.28	80.09	4-29-58	Paid 7.94
	75' 6" Transite pipe @ .70		52.50		\$207.94
	1 1 1/4" 6" Transite bend		5.10		
	1 1/4 ton 1 1/4" Stone @ 1.50		21.00		
	3 hrs. Town Shovel @ 6.50		19.50		
	1 hr. Trucking @ .75		.75		
	3 hrs. Jaeger Pump @ 1.00		3.00		
	1 hr. Rodgers Trailer @ 3.00		3.00		
	1 hr. Trucking @ 3.00		3.00		
	20 x 3 Patch		20.00		
			207.94		
	Labor				

3-5-58 Bill sent \$7.94

TOWN OF LEXINGTON—DEPT. OF PUBLIC WORKS

SEWER DIVISION

DATE.....

NO.


The undersigned applies for the construction of a particular sewer connecting No.....
 Street and hereby agrees to comply with the Rules and Regulations governing the construction and use of Particular
 Sewers, as now or at any future time established by the Board of Selectmen.

Am't of estimate \$.....

Am't Paid \$.....

..... Owner

Sketch of Service Here **//**

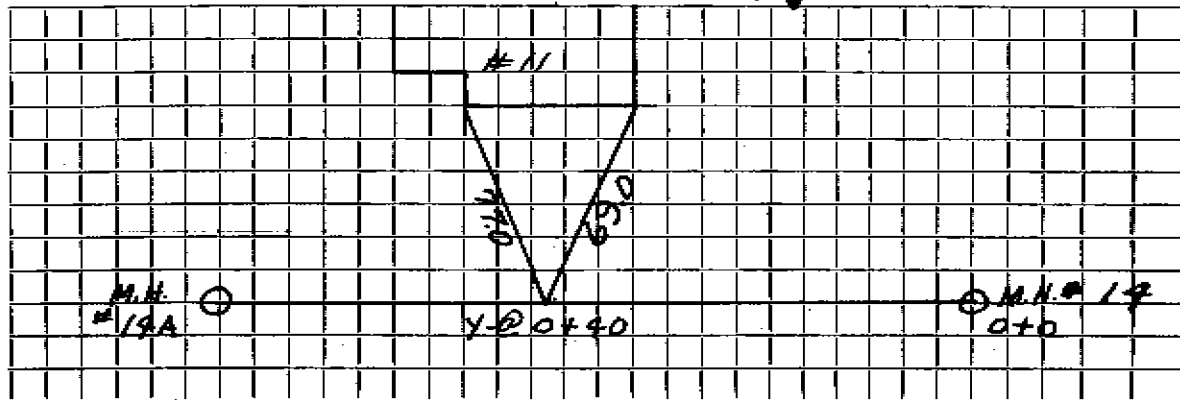

Connection made in..... Street.

Work completed..... 19..

Remarks: