

Name James H. Hoddie

Service No. 77

Address 12 Paul Revere Road

12 Paul Revere Road

Location

Kind of Pipe

Size 6"

Size of Main

~~Replacement~~ — New Service

Work Order # 4868n

Craftsman 2991

Location

MAY 9 1977

Date	Material	Amount	Total	Date	Amount
10/25/76	Labor	99 14		9-16-76	Deposit
	10% OH	9 91	109 05	2-19-80	Paid
30'	6" Transite @ 1.75		52 50		
1	11 1/4 Elbow		3 84		
1	11 1/4° X 6" Bend		6 76		
1	6" Cap		3 75		
2	Ton Cold Patch @ 12.50		25 00		
	Patch 8' X 21'		111 96		
1	6 X 8 Saddle		14 70		
3	Hrs. Shovel @ 6.50		19 50		
1	Hr. Trucking @ 3.00		3 00		
1	Hr. Loader		4 00		
	Labor		354 06		

TOWN OF LEXINGTON—DEPT. OF PUBLIC WORKS
SEWER DIVISION

DATE.....

NO.


The undersigned applies for the construction of a particular sewer connecting No.....
 Street and hereby agrees to comply with the Rules and Regulations governing the construction and use of Particular
 Sewers, as now or at any future time established by the Board of Selectmen.

Am't of estimate \$.....

Am't Paid \$.....

..... Owner

Sketch of Service Here **12**

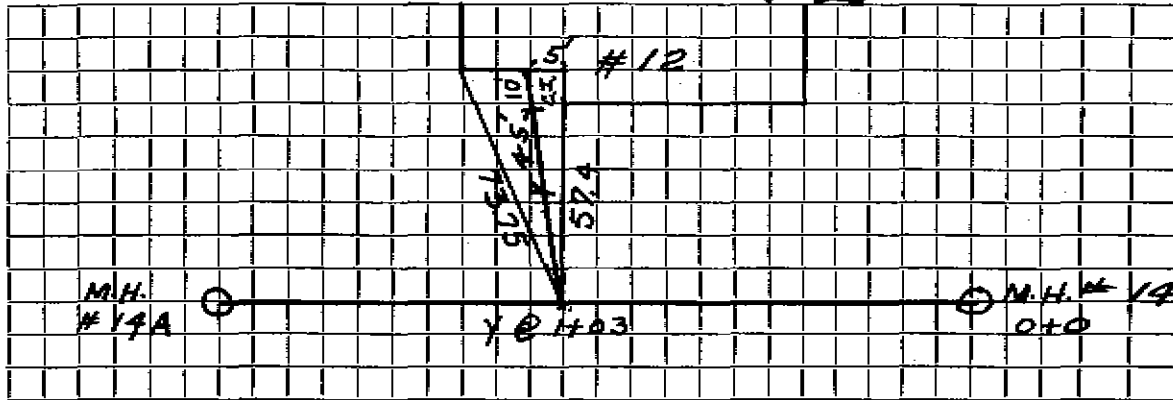

Connection made in..... Street.

Work completed.....19..

Remarks: