


SEWER DIVISION

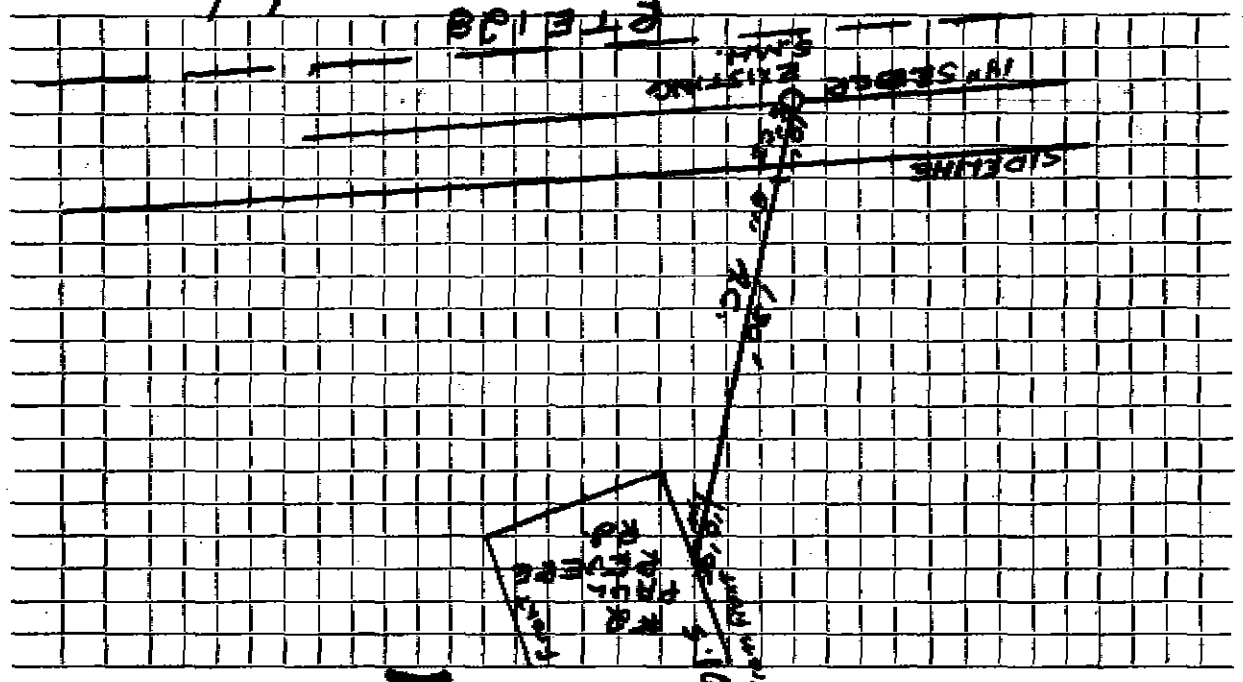

Connection made in #2 PAUL CEVECE Street.
Work completed 4/29/76
Remarks: