

Name John E. Havery

Service No. 36

Address ~~1st Constitution Road~~ 22 Paul Revere Road

22 Paul Revere Road

Location ~~Constitution~~ 8-4-58

Kind of Pipe

Size 6"

Size of Main

~~Repair~~ ~~Renewal~~ New Service

Location

Date	Material	Amount	Total	Date		Amount
4-22-58	Labor	130.18		4-2-58	Deposit	300.00
	10% overhead	13.02	143.18	8-4-58	Refund	33.94
100	6" Transite pipe @.70		70.00			266.04
10	6" Clay pipe @.435		4.35			
6	6" Cast iron pipe @ 1.74		10.44			
1	6" 90° Transite elbow		5.29			
2	6" Adapters @ 1.90		3.80			
4	hrs. Town shovel @ 6.50		26.00			
4	hrs. Trucking @.75		3.00			
			266.06			
	Labor					

TOWN OF LEXINGTON—DEPT. OF PUBLIC WORKS
SEWER DIVISION

DATE.....

NO.


The undersigned applies for the construction of a particular sewer connecting No.....
Street and hereby agrees to comply with the Rules and Regulations governing the construction and use of Particular
Sewers, as now or at any future time established by the Board of Selectmen.

Am't of estimate \$.....

Am't Paid \$.....

..... Owner

Sketch of Service Here

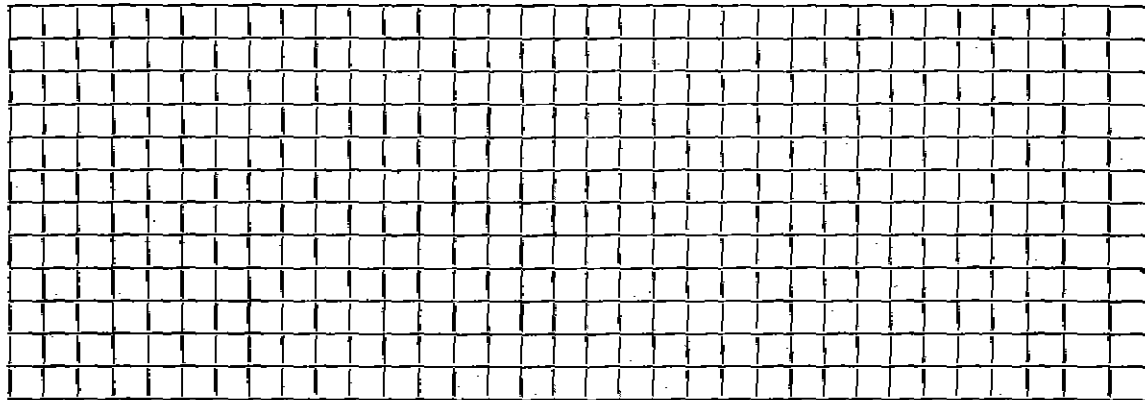

Connection made in..... Street. Work completed..... 19.....

Remarks: