

Name

Service No.

Address

27 Paul Revere Road

27 Paul Revere Road

Location

Kind of Pipe

Size 6"

Size of Main

Repair—Renewal—New Service

Location

Date	Material	Amount	Total	Date	Amount
10-28-57	79' 6" Transite			10-1-57	Deposit 200 00
				12-2-57	Refund 6 46
					193 54
	Labor				

# TOWN OF LEXINGTON—DEPT. OF PUBLIC WORKS

## SEWER DIVISION

DATE.....

NO.....


The undersigned applies for the construction of a particular sewer connecting No.....  
 Street and hereby agrees to comply with the Rules and Regulations governing the construction and use of Particular  
 Sewers, as now or at any future time established by the Board of Selectmen.

Am't of estimate \$.....

Am't Paid \$.....

..... Owner

Sketch of Service Here **27** SS. For # **27**

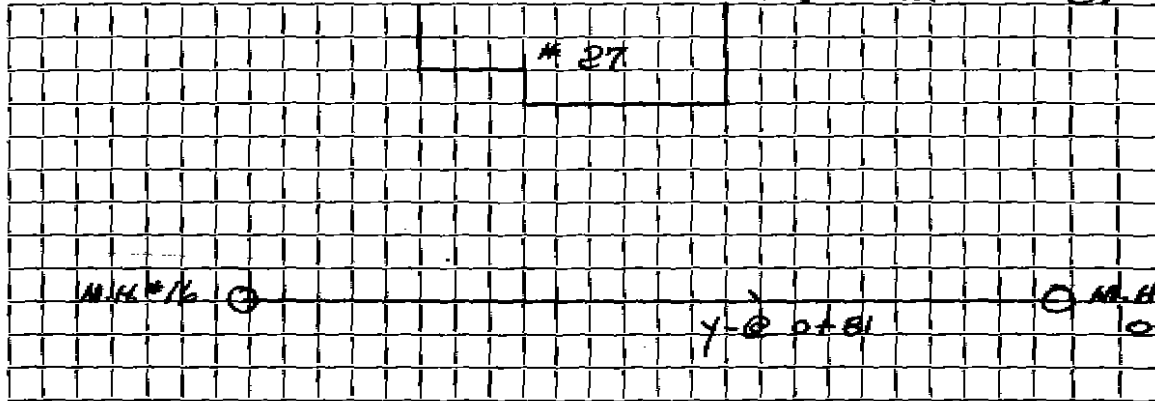

Connection made in..... Street.

Work completed.....19..

Remarks: