

Gerald Priel

Service No. 1956 -1528

1957 -148

3 PAUL REVERE RD

3 Paul Revere Road

Location

Comm. 11-18-57

Kind of Pipe

Size 6"

Size of Main

Repair—Renewal—New Service

Location

Date	Material	Amount	Total	Date	Amount
9/25/56	Labor	53 95		9-5-57	Deposit \$ 150 00
	10% overhead	5 40	59 35	12-2-57	Paid \$ 14 69
	68' - 6" Sewer pipe @ .455		30 94		\$ 164 69
	Joint compound		4 08		
	1 hr. Trucking		75		
	3 hrs. Town Shovel @ 6.50		19 50		
			114 62		
9/11/57	Labor	21 40			
	10% overhead	2 14	23 54		
	4' - 6" V.C. Sewer Pipe @ .435		17 40		
	1 - 6" Elbow		1 88		
	1 hr. Trucking		75		Bill sent 11-21-57
	1 hr. Town Shovel		6 50		\$ 14.69
			50 07		
			164 69		

**TOWN OF LEXINGTON—DEPT. OF PUBLIC WORKS
SEWER DIVISION**

DATE.....

NO.....


The undersigned applies for the construction of a particular sewer connecting No.....
Street and hereby agrees to comply with the Rules and Regulations governing the construction and use of Particular
Sewers, as now or at any future time established by the Board of Selectmen.

Am't of estimate \$.....

Am't Paid \$.....

..... Owner

Sketch of Service Here **3**

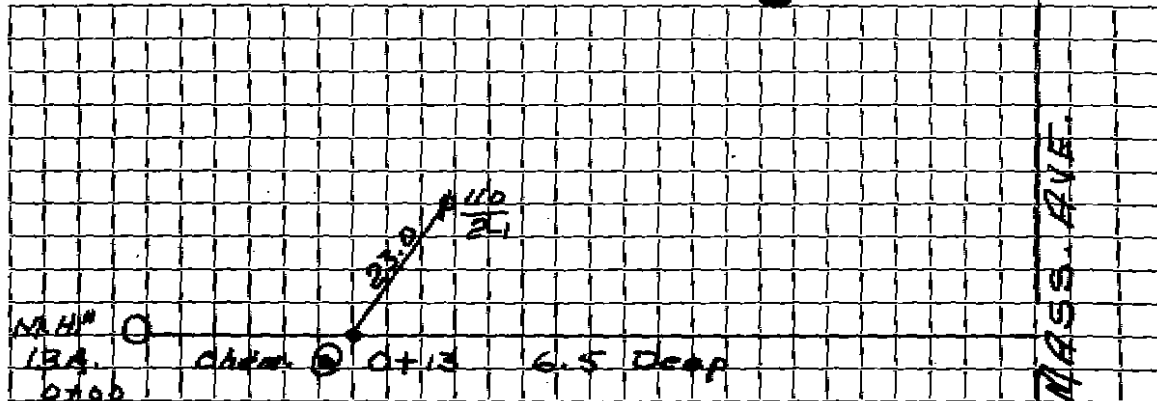

Connection made in..... Street.

Work completed.....19..

Remarks: