

Name

Service No.

Address 36 Paul Revere Road

36 Paul Revere Road

Location

Kind of Pipe

Size 6"

Size of Main

Repair—Renewal—New Service

Location

Date	Material	Amount	Total	Date	Amount
10-25-57				10-2-57	Deposit 150 00
	61' 6" Transite			12-2-57	Refund 25 09
	1 6" Clay Elbow				124 91
	Labor				

TOWN OF LEXINGTON—DEPT. OF PUBLIC WORKS
SEWER DIVISION

DATE.....


NO.....

The undersigned applies for the construction of a particular sewer connecting No.....
Street and hereby agrees to comply with the Rules and Regulations governing the construction and use of Particular
Sewers, as now or at any future time established by the Board of Selectmen.

Am't of estimate \$.....

Am't Paid \$.....

..... Owner

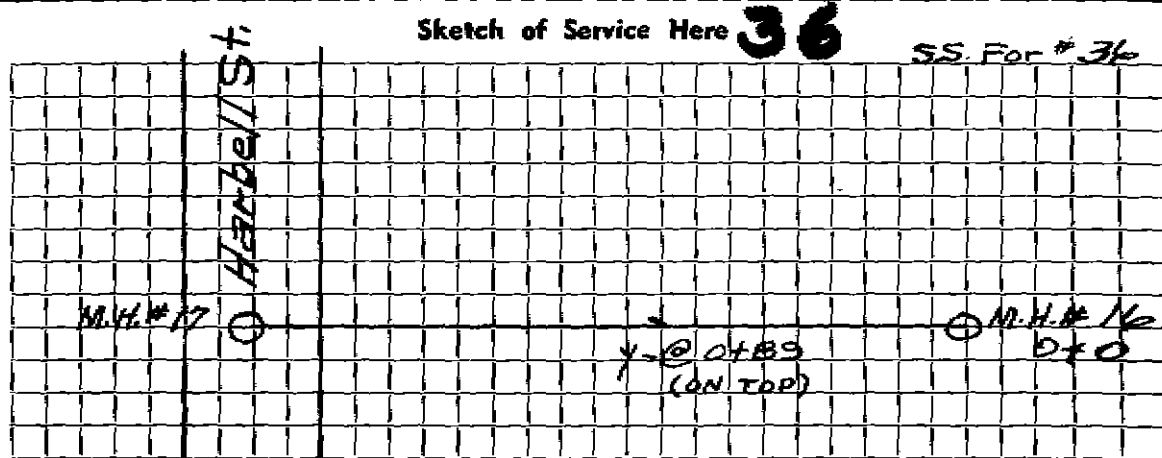

Connection made in..... Street.

Work completed..... 19..

Remarks: