

Name

Service No.

Address

42 Paul Revere Road

42 Paul Revere Road

Location

Kind of Pipe

Size 6"

Size of Main

Repair Renewal

New Service

Tocci SEAN

Location

Date	Material	Amount	Total	Date	Amount
10-23-57	55' 6" FRONSITE	20' LEFT ST. TO PROP.		9-26-57	Deposit 200 00
	1 6" 22 1/2° BEND			12-2-57	Refund 48 74
	1 6" 22 1/2° ELBOW				\$ 151 26
3/19/99	NEW PVC				
	3'8" 4" PVC				
	35' 6" PVC				
	2 6" 22° BENDS				
	1 4X6 FRANCO				
	1-6" PVC X AC FRANCO				
	Labor				

TOWN OF LEXINGTON—DEPT. OF PUBLIC WORKS

SEWER DIVISION

DATE.....


NO.

The undersigned applies for the construction of a particular sewer connecting No.....
 Street and hereby agrees to comply with the Rules and Regulations governing the construction and use of Particular
 Sewers, as now or at any future time established by the Board of Selectmen.

Am't of estimate \$.....

Am't Paid \$.....

..... Owner

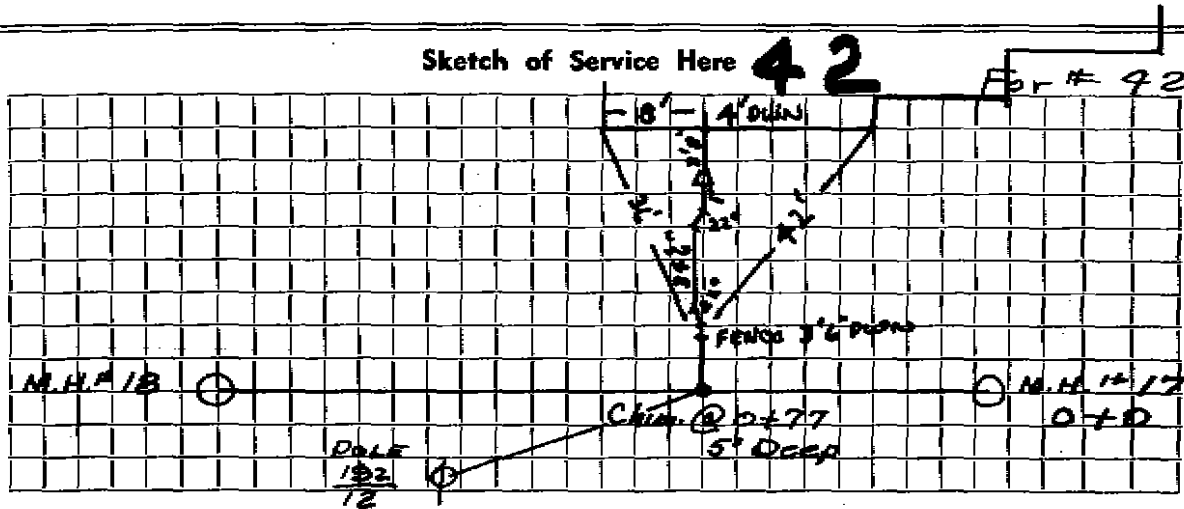

Connection made in..... Street.

Work completed.....19..

Remarks: