




DATE \_\_\_\_\_

TOWN OF LEXINGTON — BOARD OF PUBLIC WORKS  
SEWER DIVISION

Sketch of Service Here

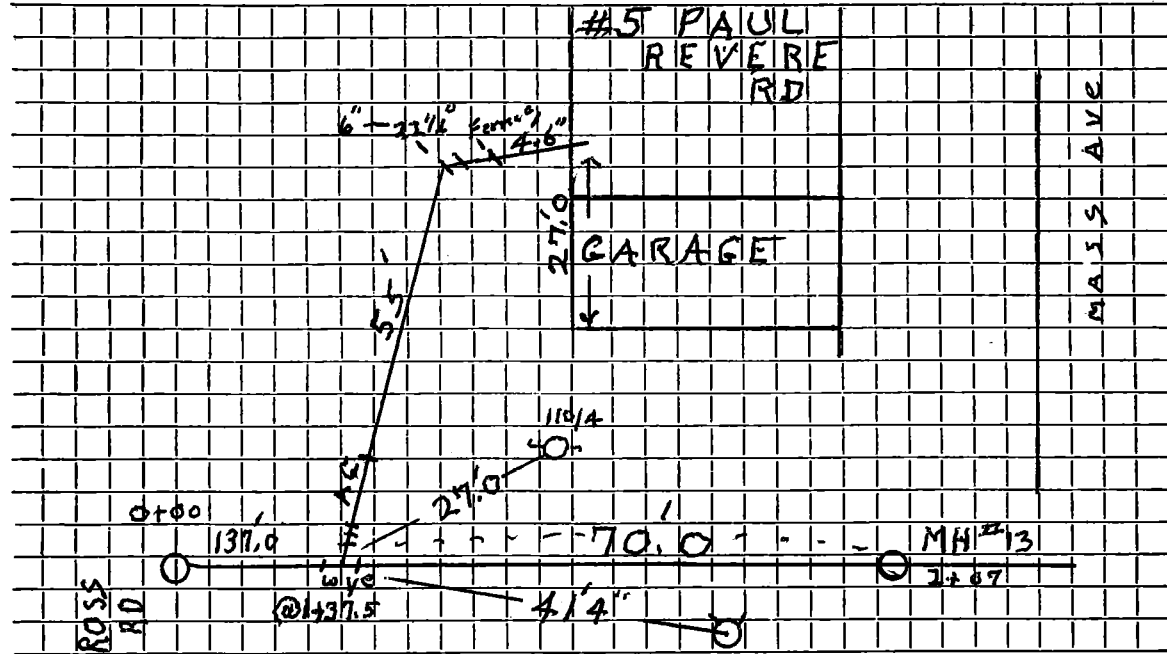

Connection made in ..... Street.

Work completed ... 5/1/10 ... Jim Males ...

Remarks: .....  
.....  
.....