

Name Kendall Garden Trust

Service No. 114

Address 51 Paul Revere Road

51 Paul Revere Road

Location

JUL 24 1978

Kind of Pipe

Size 6"

Size of Main 8"

~~Manufacturer~~ - New Service

W.O. #5944

Defelice  
Permit No. 3323

Location


Date	Material	Amount	Total	Date	Amount
4/3/78	Labor	138.48		12-1-77	Deposit 275.00
	10% O.H.	13.85	152.33	8-23-77	Paid 120.35
	<del>20' 6" Transite @1.50</del>		30.00	4-3-78	395.35
	1 <del>6" x 5' Nipple @1.75</del>		8.75		20' 6" Transite
	1 <del>6" x 22 1/2° Elbow</del>		4.05		1 6"-5' Nipple
	1 <del>6" x 11 1/4° Bend</del>		7.14		1 6"-22 1/2° Elbow
	1 <del>6" x 8" Saddle</del>		20.42		1 6"-11 1/4° Bend
	2 ton Cold Patch		29.50		1 6"x8" Saddle
	3 hrs. Trucking @3.00		9.00		
	3 hrs. Backhoe @6.50		19.50		
	Hot top 13' x 9 Patch Street		78.00	3-22-92	Main blocked with grease
	Hot top 5' x 11' Patch Sidewalk		36.66		40'
			395.35	3-26-92	Main blocked with grease
4/19/78	23'-6" ACP				13'
	10'-4" CT				

DATE \_\_\_\_\_

TOWN OF LEXINGTON — BOARD OF PUBLIC WORKS

SEWER DIVISION

Sketch of Service Here **51**

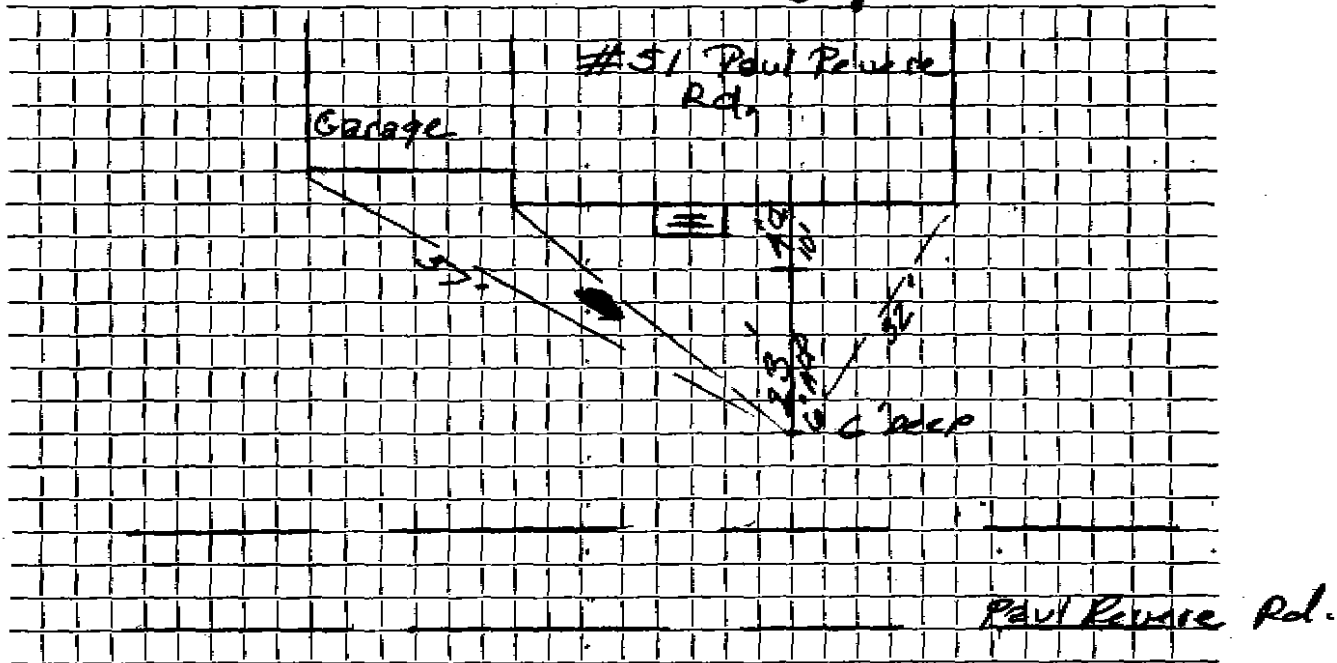

Connection made in Paul Revere Rd. Street Work completed .....

Remarks: .....  
.....  
.....