

Name William F. Caddy

Service No. 7

Address 52 Paul Revere Road

52 Paul Revere Road

Location

Kind of Pipe

Size 6"

Size of Main 8"

~~W. O. 583~~ New Service W. O. 583

Location

Date	Material	Amount	Total	Date	Amount
3-13-73	Labor	57 76		3-13-73	Deposit 600 80
3/21/73	"	20 65	78 41	5-29-73	Refund 374 10
	10% O. H.		7 84	3-13-73	225 90
	20' 6" Transite @ .90		18 00		20' 6" Transite
	1 6"x8" Saddle		15 95		1 6"-2' Nipple
	1 2'x6" nipple		2 90		1 6"x8" Wye
	1 6" cap		2 55		
	1 ton cold patch		8 00		
	10 Sq. yards patch @ 6.50		65 00		
	2 1/2 hours shovel 6.50		16 25		
	1 1/2 hours truck @ 3.00		4 50		
	1 hour pick-up truck		1 50		
	1/2 hour compressor @ 5.00		2 50		
	1/2 hour loader @ 5.00		2 50		
			225 90		
3-15-73	72' 6" Transite				


DATE _____

TOWN OF LEXINGTON — BOARD OF PUBLIC WORKS

SEWER DIVISION

Sketch of Service Here

52

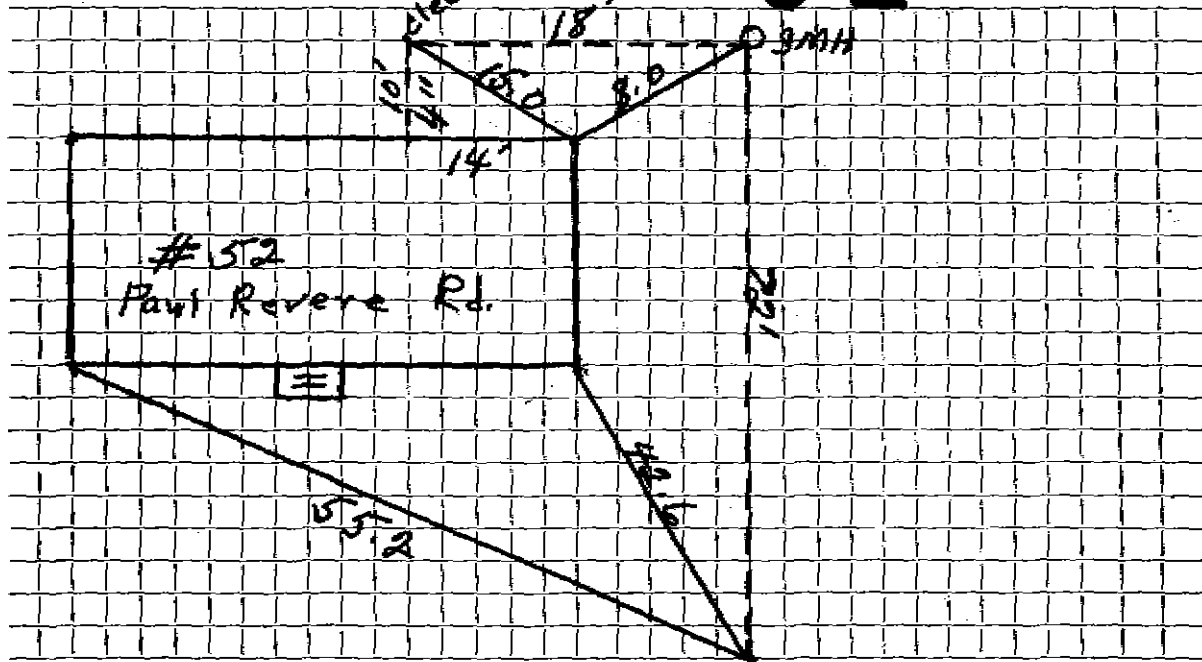

Connection made in Street. Work completed

Remarks:

