

Name **Moore Homes, Inc.**

Service No. **106**

Address **53 Paul Revere Rd.**

53 Paul Revere Road

Location

JUN 20 1977

Kind of Pipe

Size **6"**

Size of Main **8"**

~~Basic Service~~ **New Service DeFlice Bros. #2894**

Location

Date	Material	Amount	Total	Date	Amount
12/14/76	labor	66.32		12/13/76	Deposit 950.00
	10%OH	6.63	72.95	1/30/77	Refund 36.06
	20' 6" transite pipe @ 1.75		35.00	12-14-76	413.94
	1 5' X 6" nipple @ 2.03		10.15		20' 6" Transite
	1 6" cap		3.80		1 6"-5' Nipple
	1 6" X 8" saddle		20.42		1 6" X 8" Wye
	2 ton cold patch @ 12.50		25.00		
	Hot Top Sidewalk 5' X 12'		39.96		
	Hot Top Street 10' X 28'		186.66		
	2 hrs. shovel @ 6.50		13.00		
	1 hr. trucking @ 3.00		3.00		
	1 hr. loader @ 4.00		4.00		
			413.94		
1/11/77	27' 6" ACP (Transite Pipe)				
	10' 4" cast iron				

175 2 20


DATE

TOWN OF LEXINGTON — BOARD OF PUBLIC WORKS

SEWER DIVISION

Sketch of Service Here

53

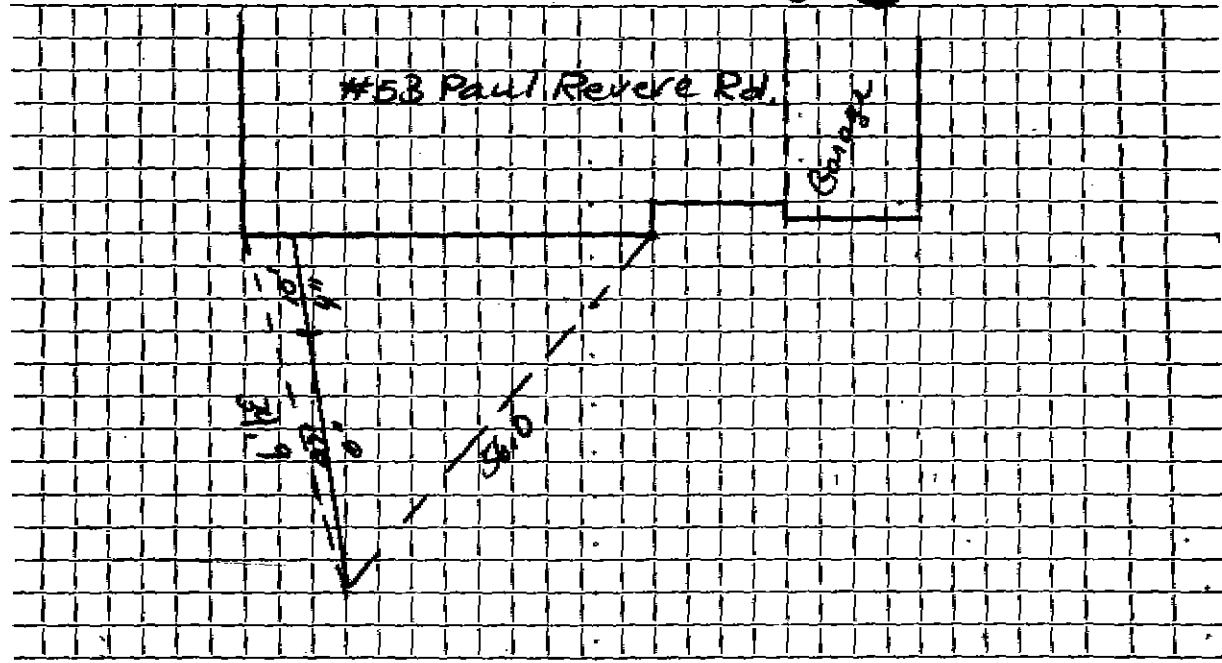

Connection made in Street. Work completed

Remarks:

.....

.....