

Name Moore Homes, Inc.

Service No. 105

Address 55 Paul Revere Rd.

JUN 20 1977

55 Paul Revere Road

Location

Kind of Pipe

Size 6"

Size of Main 8"

~~Revised~~ New Service DePalice #2893

Location


Date	Material	Amount	Total	Date	Amount
12/14/76	labor	89.56		12/9/76	Deposit 450.00
	10%OH	8.96	98.52	6/20/77	Refund 96.81
	<del>20' 6" transite pipe @ 1.75</del>		35.00	12-14-76	359.19
	<del>1 6" X 3" nipple</del>		9.90		20' 6" Transite
	<del>1 6" cap</del>		3.80		1 6" X 3" Nipple
	3 ton cold patch @ 12.50		37.50		
	30 red brick @ .2		3.60		
	1 bag cement		3.25		
	Hot Top Street 21' X 8'		111.96		
	Hot Top Sidewalk 11' X 5'		36.66		
	2 hrs. shovel @ 6.50		13.00		
	2 hrs. trucking @ 3.00		6.00		
			359.19		
3/14/77	30' 6" Transite Pipe				
	10' 4" cast iron				

DATE

# TOWN OF LEXINGTON — BOARD OF PUBLIC WORKS SEWER DIVISION

Sketch of Service Here

55

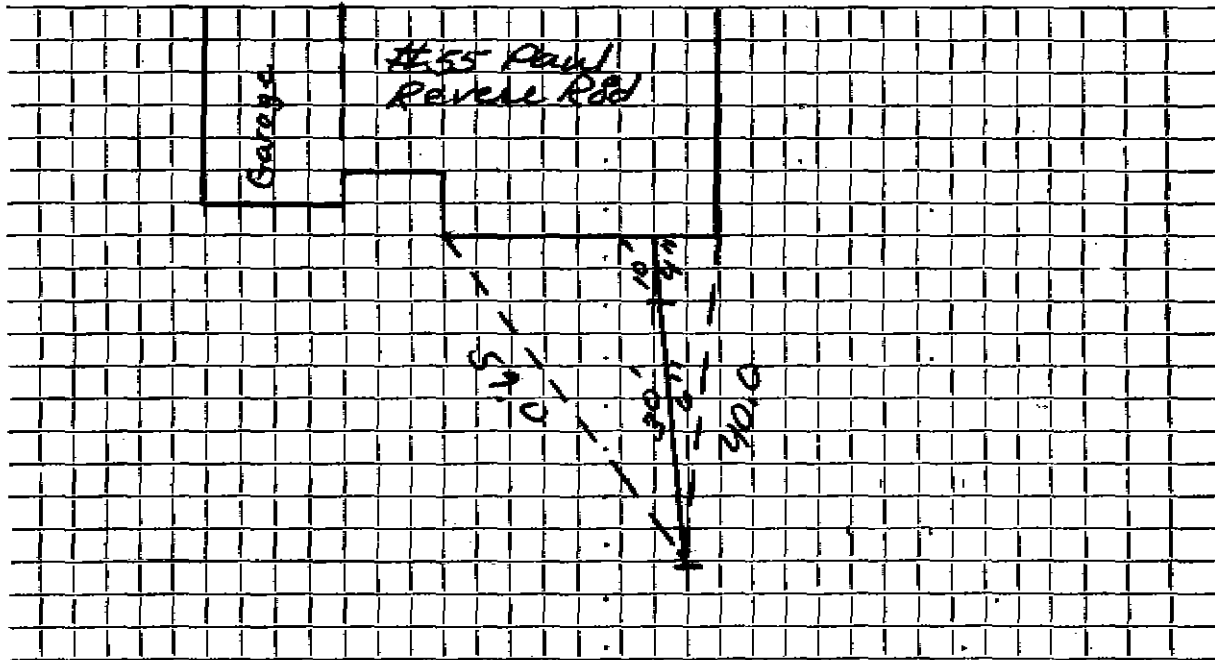

Connection made in ..... Street. Work completed .....

Remarks: .....

.....

.....

.....

.....