

Name **Richard Long**

Service No. #18

Address **58 Paul Revere Road****58 Paul Revere Road**

Location

Kind of Pipe

Size **6"**Size of Main **8"**~~XXXXXXXXXX~~ New Service WO #7102Location **Comm 6-25-62**

Date	Material	Amount	Total	Date	Amount	
4-16-62	Labor	41.39		4-2-62	Deposit	200.00
4-17-62	"	64.09	105.48	7-16-62		44.56
	10% O.H.	10.55	116.03			244.56
	55' 6" Transite Pipe @.78		42.90			
	12 1/2 Ton 3/4" Stone @1.50		18.38			
	7 Ton Gravel @.85		5.95			
	1 6" Duplex Adapter		1.90			
	1 90° Transite Elbow		5.40			
	12 X 3 Patch		12.00			
	4 Hrs. Town Shovel @6.50		26.00			
	4 Hrs. Trucking @3.00		12.00			
	1 Hr. Trojan Loader @3.00		3.00			
	1 Labor Hr. Pumping @1.00		1.00	6-14-77	Root 52' out in street	
			244.56			

TOWN OF LEXINGTON—DEPT. OF PUBLIC WORKS
SEWER DIVISION

DATE.....

NO.


The undersigned applies for the construction of a particular sewer connecting No.....
Street and hereby agrees to comply with the Rules and Regulations governing the construction and use of Particular
Sewers, as now or at any future time established by the Board of Selectmen.

Am't of estimate \$.....

Am't Paid \$.....

..... Owner

Sketch of Service Here **58**

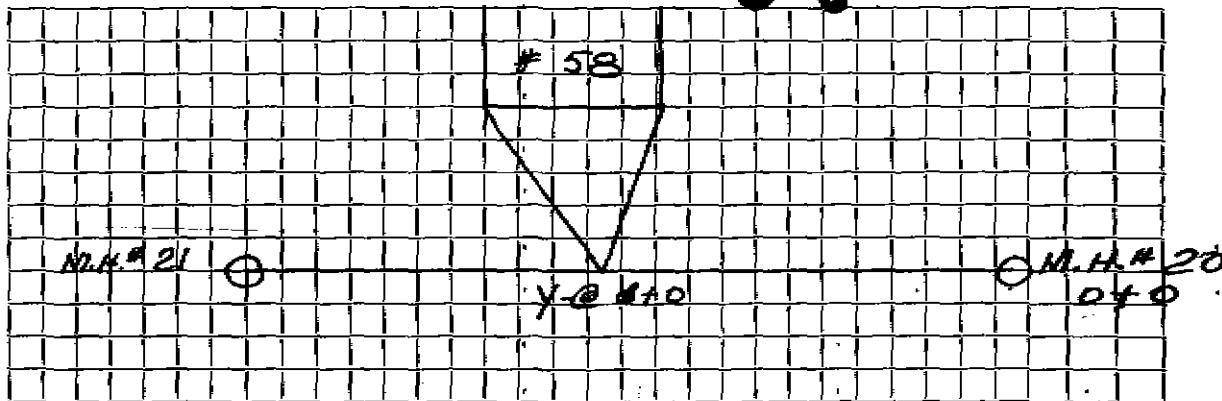

Connection made in..... Street.

Work completed..... 19..

Remarks: